APPENDIX A

ORIGINAL PEAVEY PARK PLAZA DRAWINGS

M. PAUL FRIEDBERG & ASSOCIATES

MAY 21, 1974

this page left blank intentionally

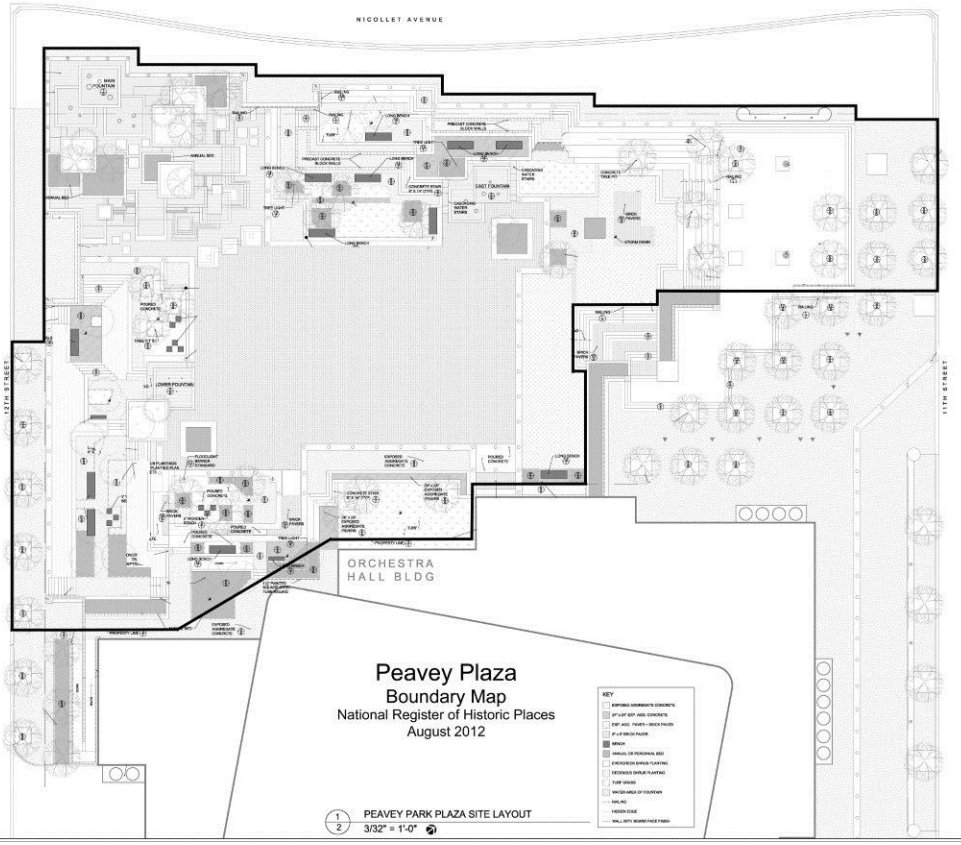

PEAVEY PARK PLAZA

CITY OF MINNEAPOLIS HENNEPIN COUNTY MINNESOTA

SHEET 01 OF 03 SHEETS

LANDSCAPE ARCHITECTURAL DRAWINGS

111 NICOLLET MALL

DRAWN BY: CLOSE LANDSCAPE ARCHITECTURE, 2007
MINNESOTA CHAPTER OF THE AMERICAN SOCIETY OF LANDSCAPE ARCHITECTS
UNITED STATES DEPARTMENT OF THE INTERIOR

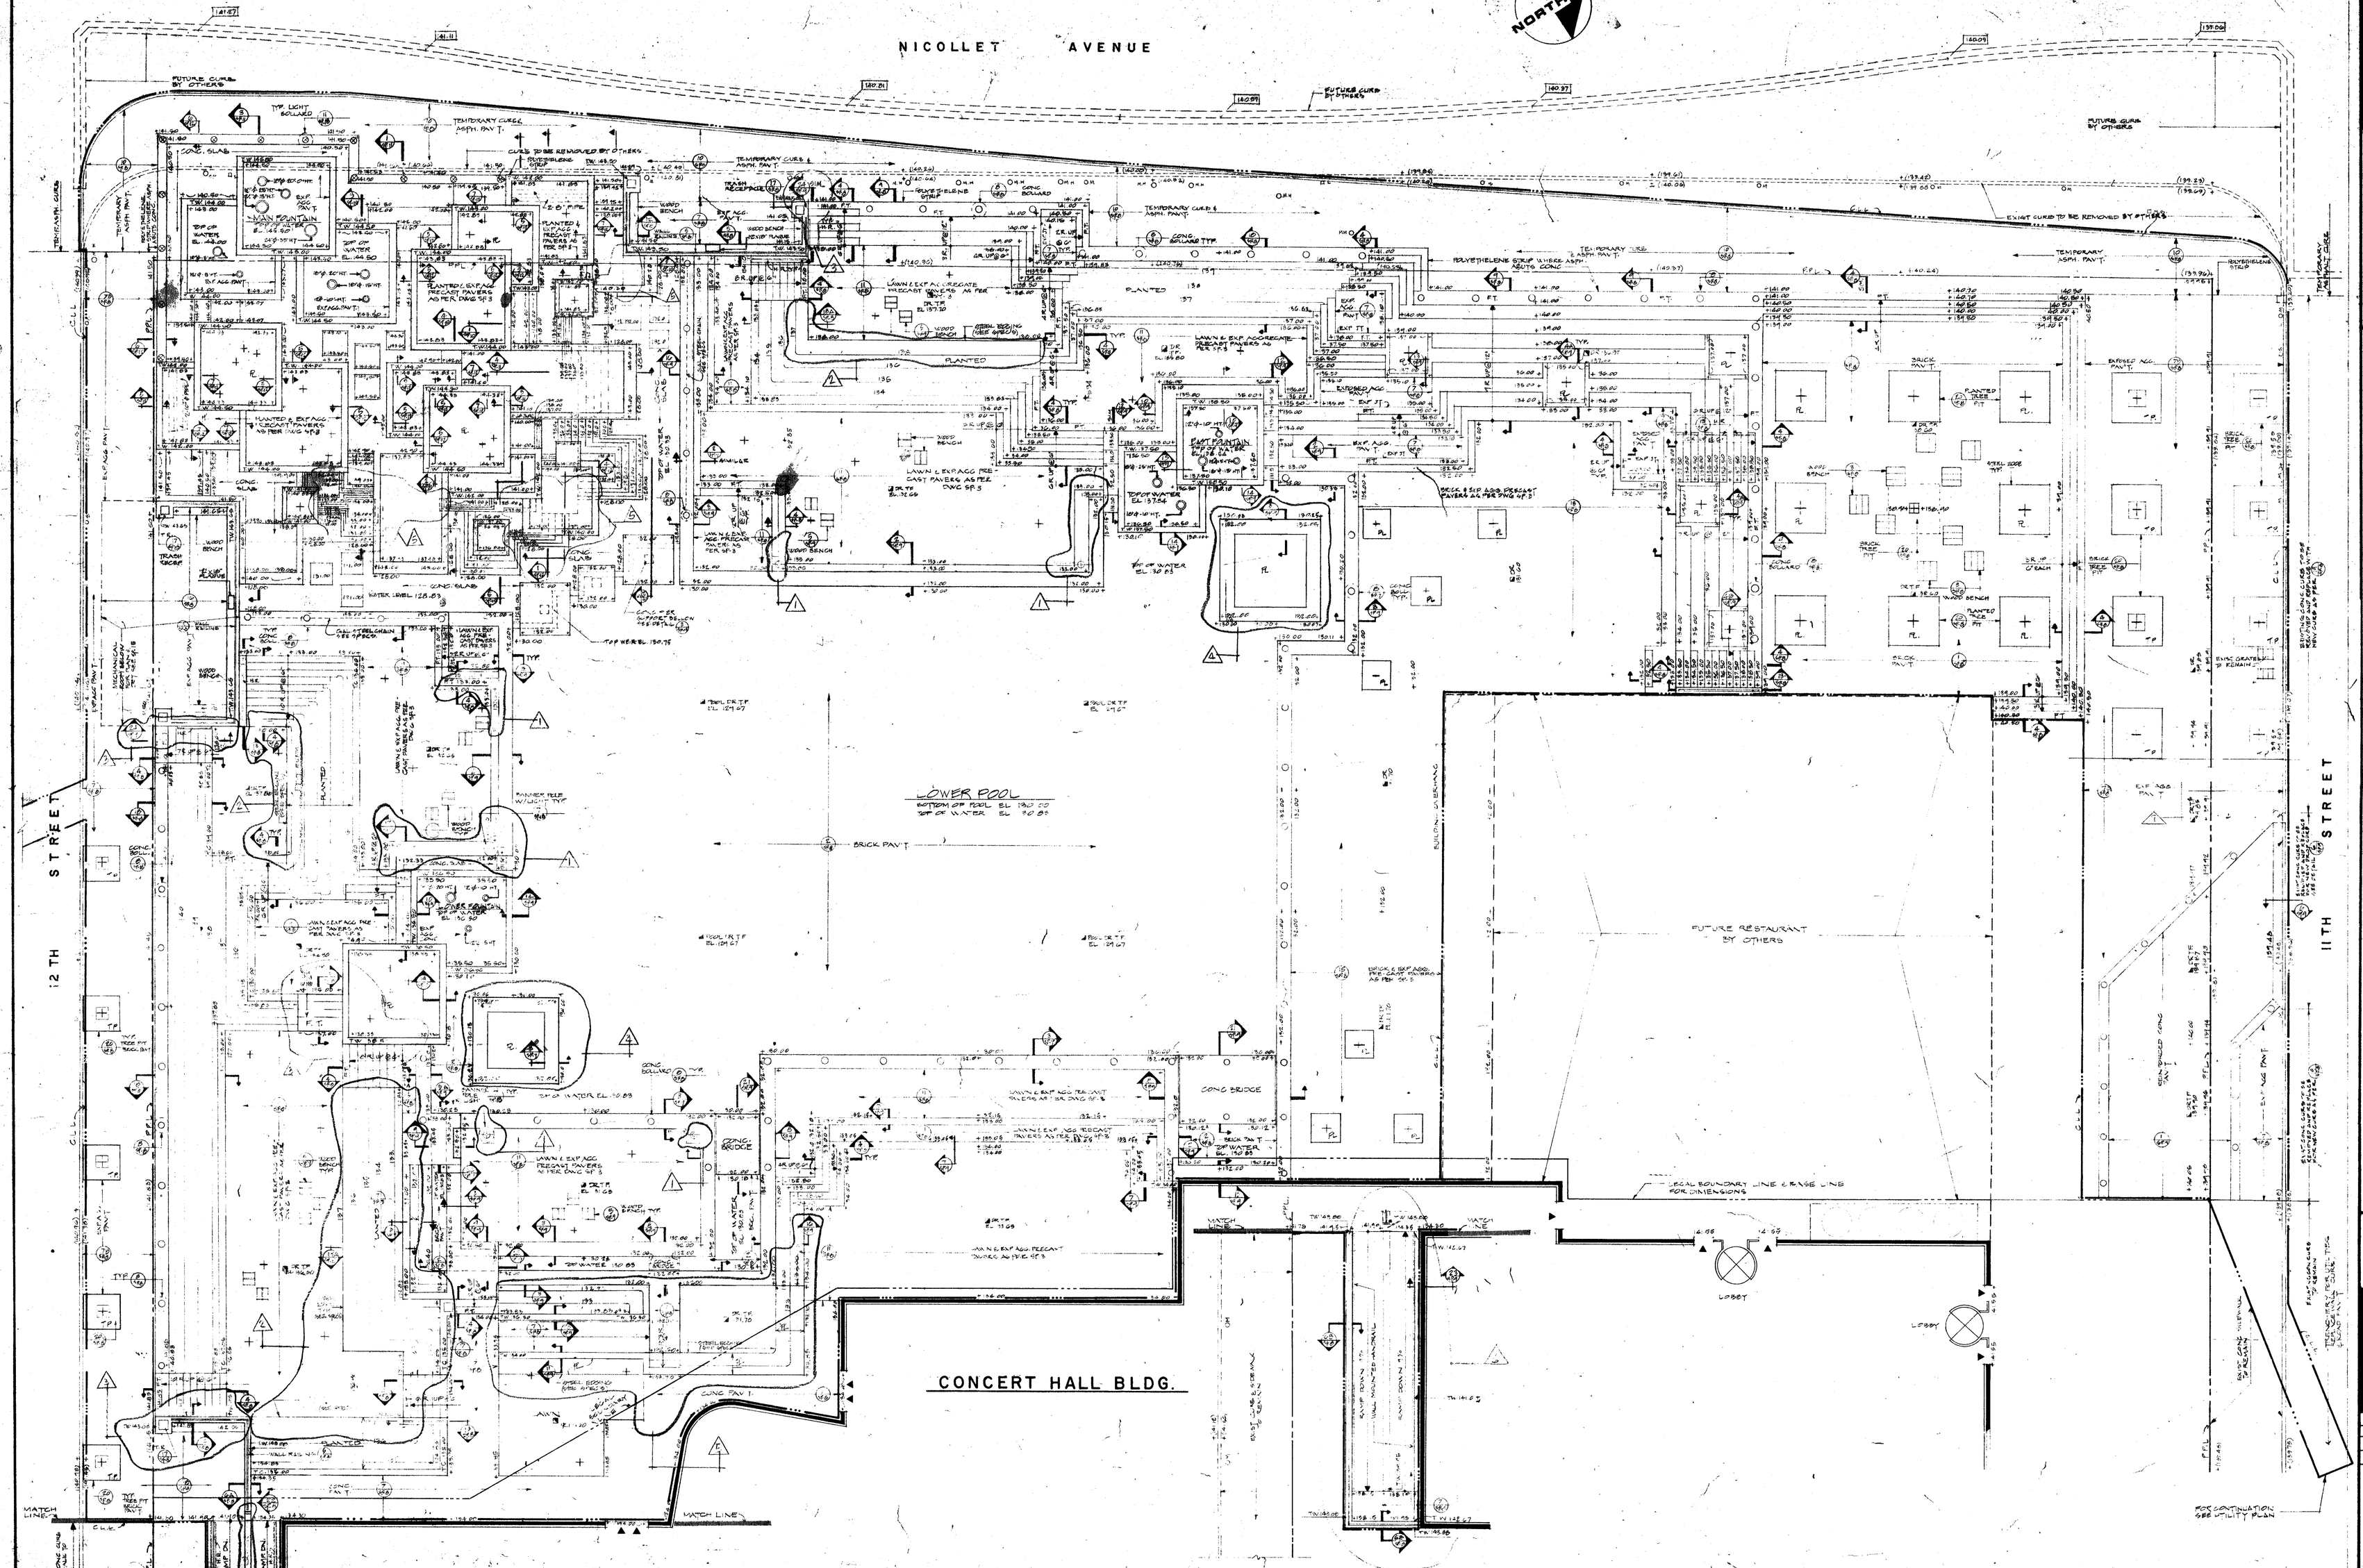

PART PLAN - RAMP AT 12' STREET - SEE MATCH LINE -

M. PAUL FRIEDBERG & ASSOCIATES

LANDSCAPE ARCHITECTURE
URBAN DESIGN

4 W. 62 ST. NEW YORK
N.Y. 10023

REGISTRATION IN MINNESOTA APPLIED FOR AND PENDING.

REVISIONS	DATE
ADDENDA #1	6-6-74
1 RELOCATED BANNER POLE REVISED PS DETAIL.	
2 PROVIDED STEEL EDGING IN LIEU OF CONC. CURB	
3 DELETED RUNNEL & HANDRAIL MOUNTED ON RUNNEL ; PROVIDED WALL MOUNTED HANDRAIL AS SHOWN	
4 REVISED WIDTH & TOP OF WALL ELEVATION OF PLANTERS AT POOL	
5 REVISED DESIGN	
6 DELETED WALL RAILING	
7 DELETED DEDUCT ALTERNATE NOTES.	

CITY OF MINNEAPOLIS
MINNEAPOLIS, MINNESOTA

PEAVEY PARK PLAZA

MINNEAPOLIS, MINNESOTA

ASSOCIATE IN CHARGE	A.C. PEARSON
PROJECT ARCHITECT	JAY A. GOLD
DRAWN BY	CHECKED BY
SCALE AS SHOWN	DATE 5-21-74

TITLE

SITE PLAN

MPF JOB # 207.3 DWG. No. SP-1

GENERAL NOTES

1. SURVEY INFORMATION SHOWN ON THESE DRAWINGS FOR UTILITIES HAS BEEN OBTAINED FROM A DRAWING ENTITLED SUB-SURFACE UTILITIES SURVEY MAP OF NICOLLET AVE., THIRTEENTH ST. -SO, ELEVENTH ST. SO. PREPARED BY WPA OF MO. 465-71-3-355 DATED FEBRUARY 1940. DWG. # PLAT NO. 41.

2. INFORMATION SHOWN ON EXISTING CONDITIONS HAS BEEN TAKEN FROM A SITE PLAN DWG # A2-1 PREPARED FOR THE CONCERT HALL FOR THE MINNESOTA ORCHESTRA PREPARED BY MANNEL GREEN & ABRAHAMSON INC. ARCHITECTS & HARDY, HOLZMAN PFEIFFER ASSOC. ASSOCIATED ARCHITECTS.

3. EACH CONTRACTOR WILL BE HELD RESPONSIBLE FOR HIS WORK. ANY DISCREPANCIES IN THE PLANS OR DETAILS SHALL BE CALLED TO THE ARCHITECT'S ATTENTION. ALL DIMENSIONS SHALL BE VERIFIED BY CONTRACTORS BEFORE STARTING WORK ON FABRICATION.

4. ALL ELEVATIONS REFER TO THE DATUM USED BY THE CITY OF MINNEAPOLIS.

5. SOIL CONDITIONS WILL BE VERIFIED BY INSPECTOR AFTER EXCAVATION, AND REPORT OF INSPECTION SUBMITTED PRIOR TO PLACING FOUNDATIONS.

6. DRAWINGS SHALL NOT BE SCALED. USE PRINTED DIMENSIONS FOR ALL CONSTRUCTION.

7. OUTSIDE FACES OF ALL EXTERIOR FOUNDATION WALLS THAT ARE IN CONTACT WITH SOIL SHALL BE DAMPPROOFED AS SPECIFIED.

8. FLOORS, PLAZAS, ETC., PROVIDED WITH DRAINS SHALL BE PITCHED TO DRAINS EXCEPT AS OTHERWISE NOTED.

9. PARTITIONS SHALL NOT BE BUILT TO FULL HEIGHT UNTIL ALL DUCTS, PIPES, ETC., ARE IN PLACE. EQUIPMENT ROOM PARTITIONS SHALL NOT BE BUILT UNTIL EQUIPMENT IS IN PLACE

10. SIZE & LOCATION OF CONCRETE PADS FOR MECHANICAL EQUIPMENT, TANKS, PUMPS, ETC. SHALL BE VERIFIED WITH MECHANICAL CONTRACTORS BEFORE PLACEMENT OF CONCRETE.

11. ALL EXPOSED CONCRETE CORNERS SHALL HAVE A ¾" ROUNDING UNLESS OTHERWISE SHOWN

LEGEND

- PROJECT PROPERTY LINE
- CONTRACT LIMIT LINE
- LEGAL BOUNDRY LINE
- MATCH LINE
- EXISTING GRATE
- EXISTING MAN HOLE
- PROPOSED CATCH BASIN
- STREET CATCH BASIN (SEE PLUMBING DRWGS.)
- PROPOSED DRAIN
- CENTERLINE
- PLANTED
- PROPOSED TREE
- LEGAL GRADE
- +(4160) EXISTING SPOT ELEVATION
- +141.60 NEW SPOT ELEV.
- ...98.... EXISTING CONTOUR
- 140 PROPOSED CONTOUR
- ELEVATION
- SECTION
- BANNER POLE WITH LIGHT
- TREE LIGHT
- EXISTING LIGHT TO REMAIN
- TRAFFIC SIGN
- PARKING METER
- BOLLARD
- LIGHT BOLLARD
- BANNISTERS

ABBREVIATIONS

ALUM.	ALUMINUM
ARCH.	ARCHITECTURAL
A.C.P.	ASBESTOS CEMENT PIPE
ASPH.	ASPHALT
@	AT
B & B	BALL AND BURLAP
BRK.	BRICK
CAL.	CALIPER
C.I.P.	CAST IRON PIPE
C.B.	CATCH BASIN
C	CENTER LINE
C.C.	CENTER TO CENTER
CL.	CLEARANCE
C.W.	COLD WATER
CONC.	CONCRETE
C.L.L.	CONTRACT LIMIT LINE
DET.	DETAIL
	DIAMETER
DIA.	DIAMETER
D.	DOWN
DR.	DRAIN
DWGS.	DRAWINGS
ELEC.	ELECTRICAL
EL.	ELEVATION
ELEV.	ELEVATION
EQ.	EQUAL
EX.	EXISTING
EXIST.	EXISTING
EXP. JT.	EXPANSION JOINT
FIN. GR.	FINISHED GRADE
GALV.	GALVANIZED
GA.	GAUGE
HT.	HEIGHT
INV.	INVERT
L.P.	LIGHT POLE
M.H.	MANHOLE
N.	NORTH
NO.	NUMBER
O.C.	ON CENTER
O.D.	OUTSIDE DIAMETER
PAV'T.	PAVEMENT
P.C.P.	POROUS CONCRETE PIPE
P.P.L.	PROJECT PROPERTY LINE
QUAN.	QUANTITY
R.	RADIUS
REINF.	REINFORCED
R.C.P.	REINFORCED CONCRETE PIPE
SIM.	SIMILAR
SPEC'S.	SPECIFICATIONS
SQ.	SQUARE
STRUCT.	STRUCTURAL
T.C.	TOP OF CURB
T.F.	TOP OF FRAME
T.W.	TOP OF WALL
T.R.	TRASH RECEPTACLE
TR.	TREAD
T.P.	TREE PIT
TYP.	TYPICAL
W.B.	WASTE BASKET
W.	WATER
W.P.	WATER PROOFING
W.H.V.	WATT HERCURY VAPOR
W.W.F.	WELDED WIRE FABRIC
T.B.	TOP OF BENCH
W.S.	WATER STOP
E.W.	EACH WAY
E.F.	EACH FACE

LIST OF DRAWINGS

SP-1-A - Notes Legend & Abbreviations
SP-1 - Site Plan 1/8"
SP-2 - Dimension Plan 1/8"
~~SP-3 - Pavement Pattern Plan 1/8"~~
SP-4 - Plumbing Plan 1/8"
SP-5 - Electrical Plan 1/8"
SP-6 - Utility Plan 1/16"
~~SP-7 - Planting Plan 1/16"~~
SP-8 - Site Improvement Details
SP-9 - Site Improvement Details
SP-10 - Site Improvement Details
SP-11 - Site Improvement Details
SP-12 - SITE IMPROVEMENT DETAILS
SP-13 - SITE IMPROVEMENT DETAILS
SP-14 - FOUNTAIN WEIR PLAND AND DETAILS
SP-15 - MECHANICAL ROOM PLAN & DETAIL
SP-16 - PLUMBING DETAILS
SP-17 - MECHANICAL ROOM PLUMBING PLAN & DETAILS
SP-18 - ELECTRICAL DETAILS
SP-19 - MAIN FOUNTAIN & FUNDATION PLAN

M. PAUL FRIEDBERG & ASSOCIATES

LANDSCAPE ARCHITECTURE
URBAN DESIGN

4 W. 62 ST. NEW YORK
N.Y. 10023

REGISTRATION IN MINNESOTA APPLIED FOR AND PENDING

REVISIONS	DATE

CITY OF MINNEAPOLIS
MINNEAPOLIS, MINNESOTA

PEAVEY PARK PLAZA
MINNEAPOLIS, MINNESOTA

ASSOCIATE IN CHARGE	A.C. PEARSON
PROJECT ARCHITECT	JAY A. GOLD
DRAWN BY	CHECKED BY
SCALE	DATE 5-21-74

TITLE

NOTES LEGEND AND ABBREVIATIONS

MPF JOB #	DWG. No.
2073	SP-1A

NICOLLET AVENUE

NORTH

12TH STREET

11TH STREET

CONCERT HALL BLDG.

PART PLAN - RAMP AT 12 STREET - SEE MATCH LINE

M. PAUL FRIEDBERG & ASSOCIATES

LANDSCAPE ARCHITECTURE
URBAN DESIGN

4 W. 62 ST. NEW YORK
N.Y. 10023

STATE OF NEW YORK
BENJAMIN WATKINS
NO. 25178
LICENSED PROFESSIONAL ENGINEER

*REGISTRATION IN MINNESOTA APPLIED FOR AND PENDING.

REVISIONS	DATE
ADDENDA #1	6-6-74
1 REVISED DIMENSIONS	

CITY OF MINNEAPOLIS
MINNEAPOLIS, MINNESOTA

PEAVEY PARK PLAZA

MINNEAPOLIS, MINNESOTA

ASSOCIATE IN CHARGE	A.C. PEARSON
PROJECT ARCHITECT	JAY A. GOLD
DRAWN BY	CHECKED BY
SCALE 1/8" = 1'-0"	DATE 5-21-74

TITLE

DIMENSION PLAN

MPF JOB # 2073

DWG. No. SP-2

NICOLLET AVENUE

FUTURE ZONE BY OTHERS

NORTH

12 TH STREET

11TH STREET

CONCERT HALL BLDG.

LEGAL BOUNDARY LINE

RAMP DOWN

BENCH

NOTE: FOR CONTINUATION SEE DWG SP-5

NOTE: FOR CONTINUATION SEE DWG SP-6

MATCH LINE

LEGEND

- FOUNTAIN MECHANICAL LINES
- STORM DRAINAGE LINES
- VACUUM LINES
- HOSE BIB LINES
- SANITARY WASTE LINES

PART PLAN RAMP AT 12 STREET SEE MASTER LINE

M. PAUL FRIEDBERG & ASSOCIATES

LANDSCAPE ARCHITECTURE
URBAN DESIGN

4 W. 58 ST. NEW YORK
N.Y. 10023

REGISTERED IN MINNESOTA APPLIED FOR AND PENDING

REVISIONS	DATE
△ DEPEND. No. 1	6-5-74
1 RELOCATED GRATES & VALVES & FOUNTAIN WELL	
2 RELOCATED DRAIN	
3 DRAIN INVERT ELEVATIONS & SPEED	

CITY OF MINNEAPOLIS
MINNEAPOLIS, MINNESOTA

PEAVEY PARK PLAZA

MINNEAPOLIS MINNESOTA

ASSOCIATE IN CHARGE	A.C. PEARSON
PROJECT ARCHITECT	JAY A. GOLD
DRAWN BY	CHECKED BY
SCALE 1/8"=1'-0"	DATE 5-21-74

TITLE

PLUMBING PLAN

MPF JOB # 2073 | DWG. NO. SP-4

NICOLLET AVENUE

12TH STREET

11TH STREET

MECHANICAL RM. BELOW SEE DWG.# SP-13

CONCERT HALL BLDG.

STAGE LIGHTS

(2) SOUND CABLES, 3/4"C

(3) PAIR 3/4"C LOUDSPEAKERS

(5) PAIR 3/4"C MIC CABLES TO SOUND BOOTH

1100A, 4 WIRE, 120/208V, 1Ø RECEPTACLE RUSSELL & STOLL #RCR-3334 FOR PORTABLE PANEL PROVIDE MATCHING PLUG CAP TO OWNER.

FLUSH WITH TOP OF BOX IN LAWN

PLANTED PERIM. DN.

RAMP DN.

MATCH LINE J

PART PLAN - RAMP AT 12TH STREET

FUTURE RESTAURANT BY OTHERS

SYMBOLS

- BANNER POLE & CONCRETE BASE - SEE 6/SP-8 & 7/SP-8 WITH LOUDSPEAKERS AND/OR STAGE LIGHTS AS SHOWN
- FOUNTAIN FIXTURE, FLEXIBLE CABLE AND STYRENE CONDUIT - SEE 4/SP-8
- FOUNTAIN RECEPTACLE BOX - SEE 5/SP-8
- FLUSH LAWN RECEPTACLE BOX, CROUSE HINDS #WJBF100604 OR EQUAL WITH RECEPTACLES, COVERS AND CONDUIT SEALS AS IN TYPE "J2" EXCEPT THAT INTERNAL SPLICE BOX NOT REQUIRED. USE CAST EPOXY SPLICES.
- TREE MOUNTED CAST METAL JUNCTION BOX WITH WEATHERPROOF GASKET, SHIM MOUNT 1/2" FROM TREE WITH MACHINE-WOOD THREADED LAC SCREWS, DOUBLE NUTS AND LOCKWASHER. USE CABLE SEALS CROUSE HINDS #CGS OR EQUAL AT CABLE EXITS.
- FLUSH TYPE WEATHERPROOF JUNCTION BOX, WALL OR STEP MOUNTED, CROUSE HINDS #WJBF060404 OR EQUAL. CHANGE SIZE TO SUIT WIRING AND CONDUIT ENTRIES.
- WELL LIGHT TO UPLIGHT TREES - SEE 10/SP-8
- HANGING TREE LIGHT, STAINLESS STRAP HANGER, SWIVEL SOCKET AND SEALED FLEXIBLE SUPPLY CORD - SEE 8/SP-8 & 10/SP-8
- BOLLARD LIGHT ATOP CONCRETE BOLLARD - SEE 11/SP-8
- FLOW SWITCH, SUPPLIED BY PLUMBING CONTRACTOR - SEE 11A/SP-8 PROVIDE CABLE, SEAL AND 4 WIRE 3 POLE CONNECTOR SET IN "J2" BOXES.
- MOTOR, SUPPLIED BY PLUMBING CONTRACTOR (EXCEPT FAN) FOR SUBMERSIBLE PUMPS ONLY, WITH 10 FOOT CABLE. PROVIDE TRIPLE SEALED CONNECTOR SET IN "J2" BOX - SEE
- WEATHERPROOF, FLUSH MOUNTED 20 AMP, 120 VOLT RECEPTACLE AS SPECIFIED.
- MICROPHONE & LOUDSPEAKER JACKS IN LOCKABLE WEATHERPROOF-VANDALPROOF FLUSH ENCLOSURE, PASS & SEYMOUR #4800-MSJ-46 OR EQUAL.
- CONDUIT AND WIRE IN OR BELOW EARTH AND/OR CONCRETE (PER SPECIFICATIONS) OR CONCEALED IN MECHANICAL ROOM CONSTRUCTION.
- B — BRASS OR COPPER CONDUIT AND WIRE IN OR BELOW EARTH AND/OR CONCRETE.
- S — 4" STYRENE CONDUIT TERMINATED PER DETAILS 4/SP-8 & 5/SP-8 TO PERMIT REMOVAL OF FOUNTAIN LIGHTS, MOTOR AND FLOW SWITCH.
- MI — MINERAL INSULATED CABLE ASSEMBLY IN OR UNDER CONCRETE AND EARTH AND EXPOSED UP SIDE OF TREE TO "J" BOX, 2 #10 TYPE UNLESS NOTED OTHERWISE.
- HOME RUN TO PANEL AND CIRCUITS INDICATED IN TYPE OF ENCLOSURE SHOWN.
- CONDUIT AND WIRE EXPOSED AND/OR CONCEALED IN MECHANICAL ROOM CONSTRUCTION.
- S↓P — WEATHERPROOF TOGGLE SWITCH-WALL MOUNTED 4'-2" ABOVE FLOOR, HUBBELL # 1CM51 OR EQUAL.
- 100 A. — FUSED SERVICE SWITCH PER SPECIFICATIONS AND DRAWINGS-NUMERAL INDICATES SIZE.
- MOTOR CONTROLLER WITH SWITCH LOCKABLE IN OPEN POSITION.

M. PAUL FRIEDBERG & ASSOCIATES

LANDSCAPE ARCHITECTURE URBAN DESIGN

4 W. 62 ST. NEW YORK N.Y. 10023

REGISTERED IN MINNESOTA & AFFILIED PPR AND PENDING.

REVISIONS		DATE
1	RELOCATION OF JUNCTION BOX AND PORTABLE PANEL.	
2	RELOCATION OF BANNER POLES.	

CITY OF MINNEAPOLIS
MINNEAPOLIS, MINNESOTA

PEAVEY PARK PLAZA

MINNEAPOLIS MINNESOTA

ASSOCIATE IN CHARGE	A.C. PEARSON
PROJECT ARCHITECT	JAY A. GOLD
DRAWN BY	D.D.
CHECKED BY	E.F.
SCALE	1/8
DATE	6-21-74
TITLE	ELECTRICAL PLAN
MPF JOB #	
DWG. No.	SP-5

NICOLLET AVENUE

NORTH

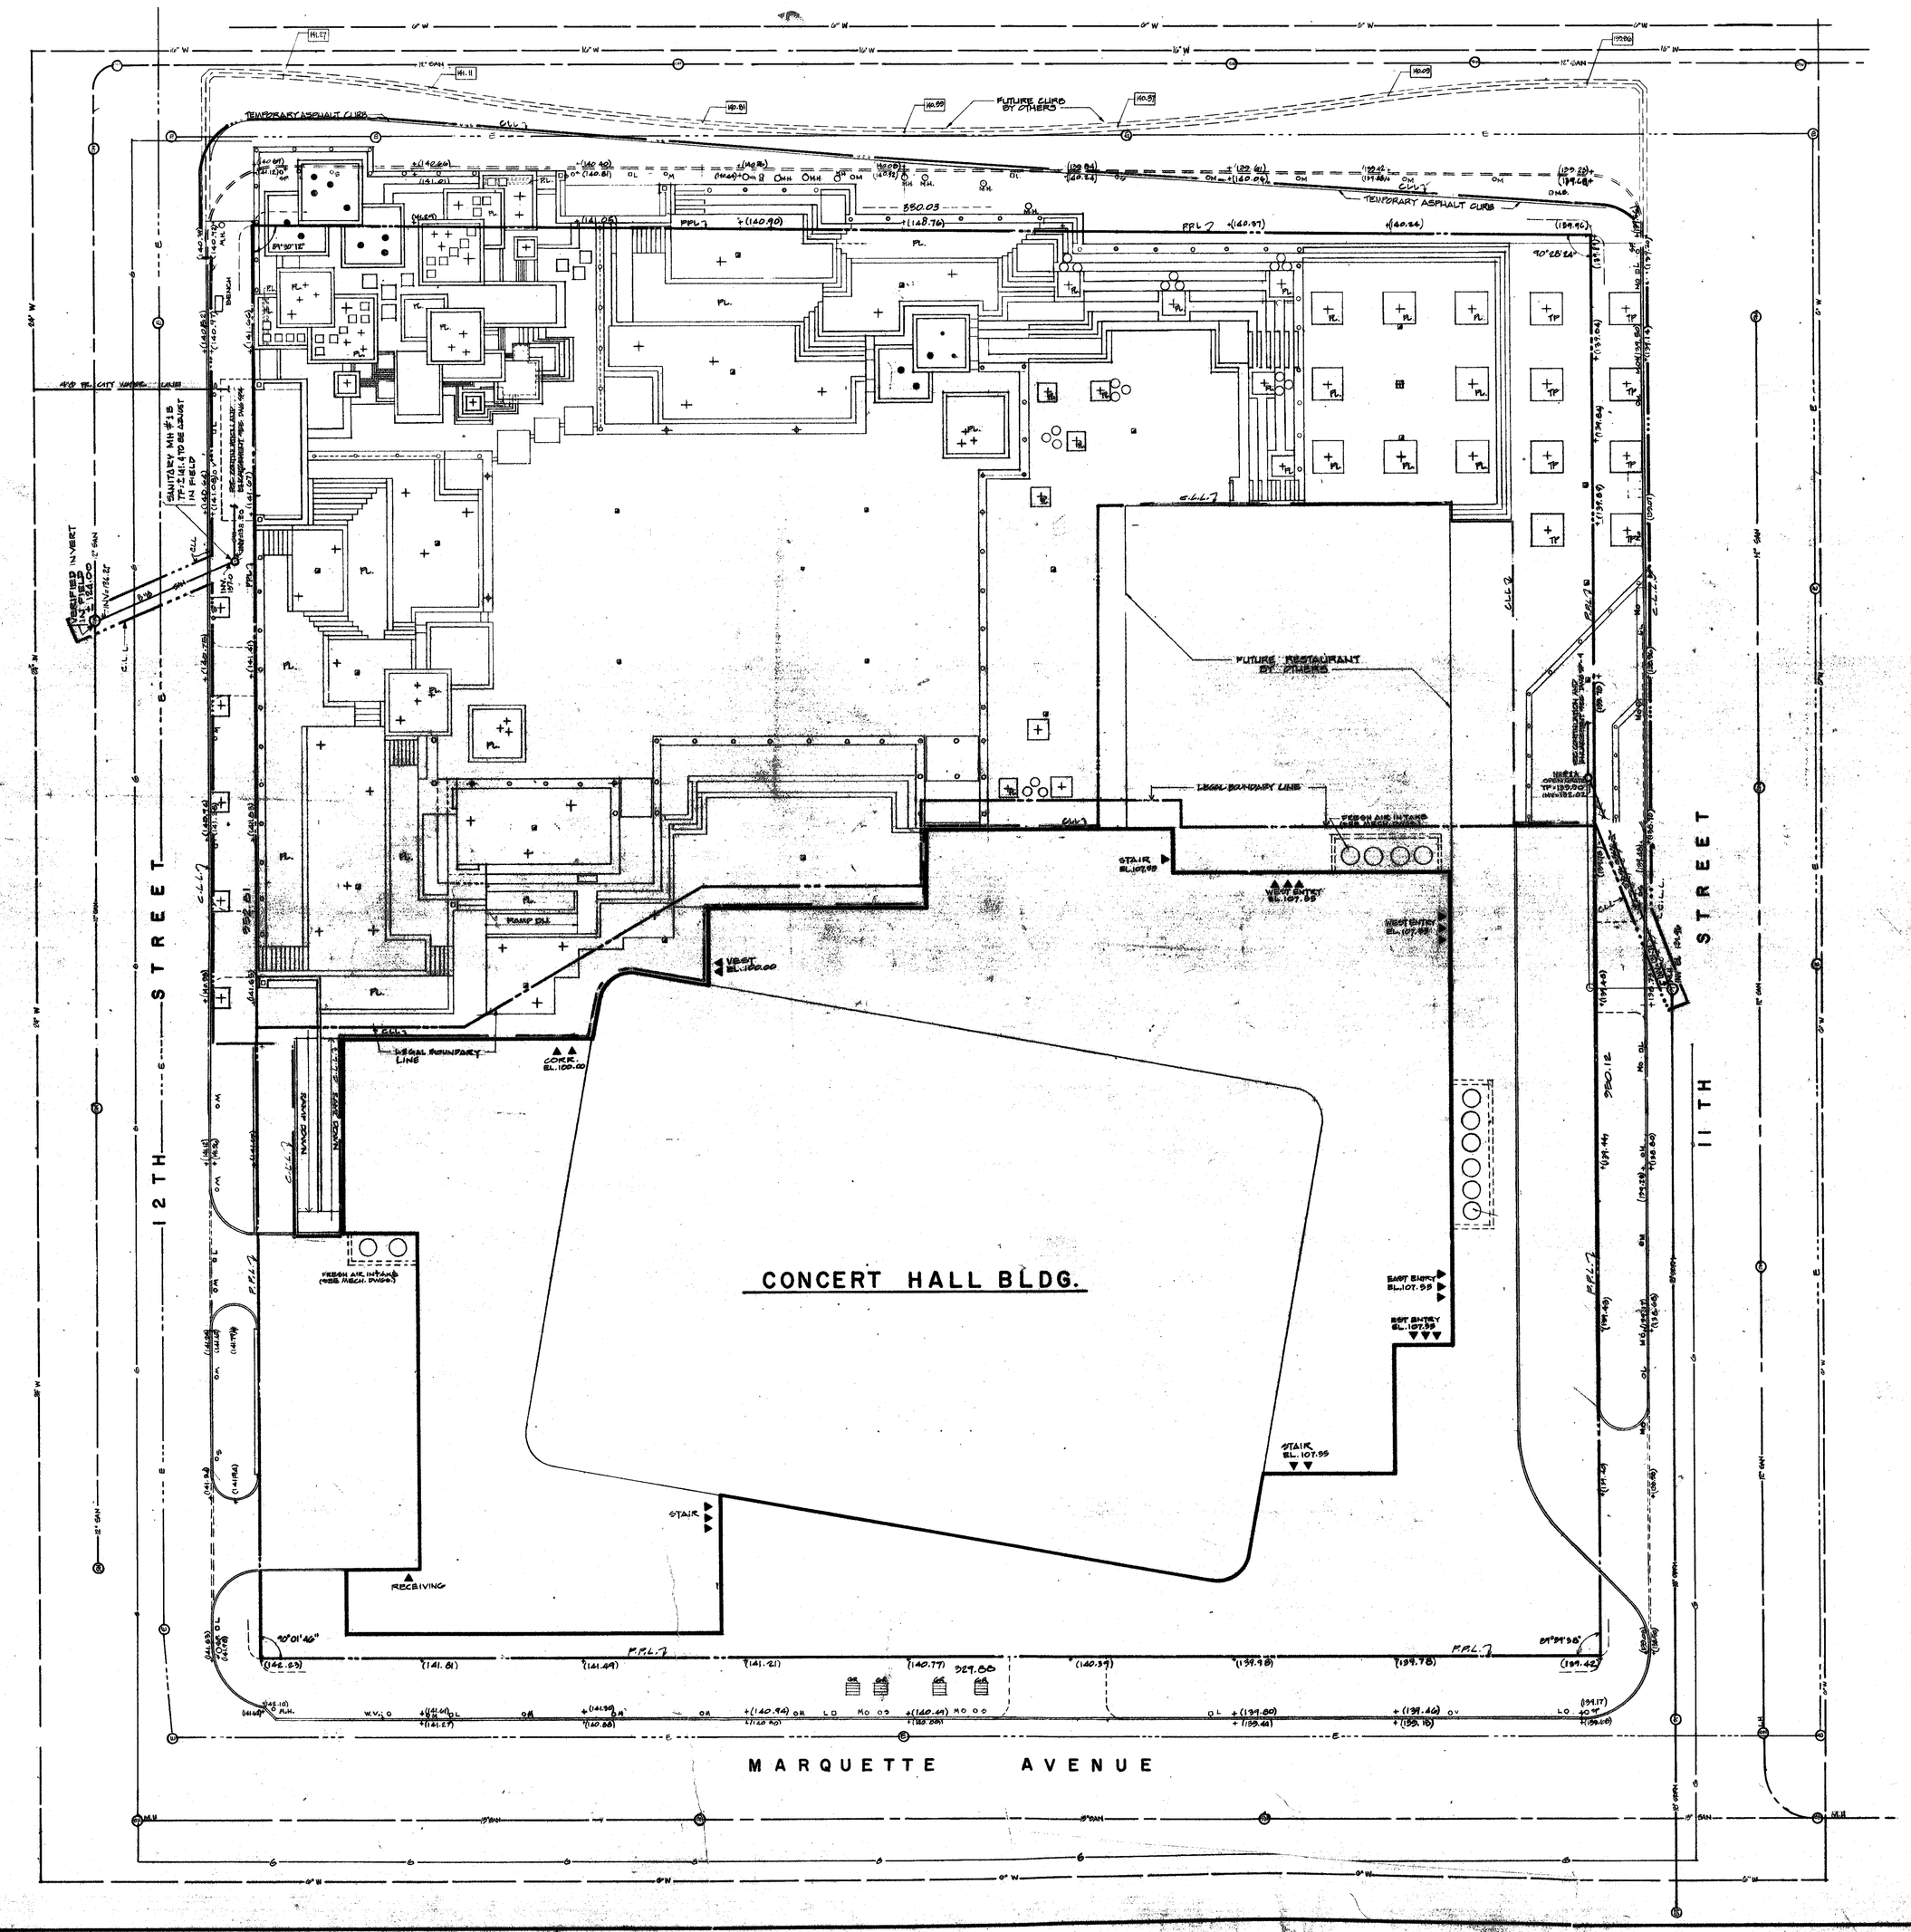
12TH STREET
11TH STREET
MARQUETTE AVENUE
CONCERT HALL BLDG.
FUTURE RESTAURANT BY OTHERS
FUTURE CURB BY OTHERS
TEMPORARY ASPHALT CURB
LEGAL BOUNDARY LINE
RECEIVING
STAIR

PAVEMENTS

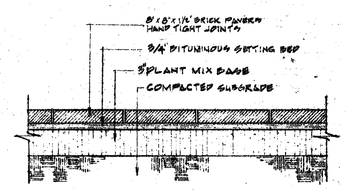

1 BRICK PAVEMENT
SCALE: 1½"=1'-0"

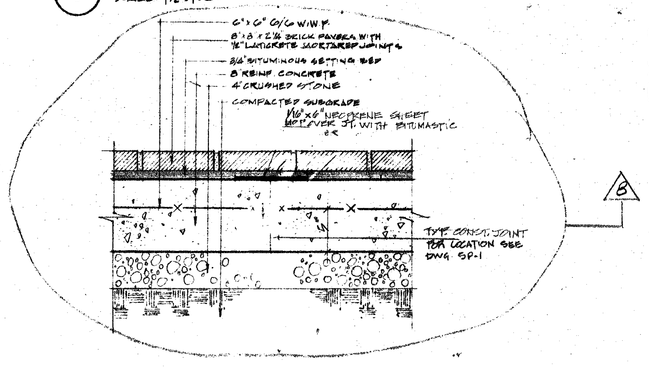

2 BRICK POOL BOTTOM
SCALE: 1½"=1'-0"

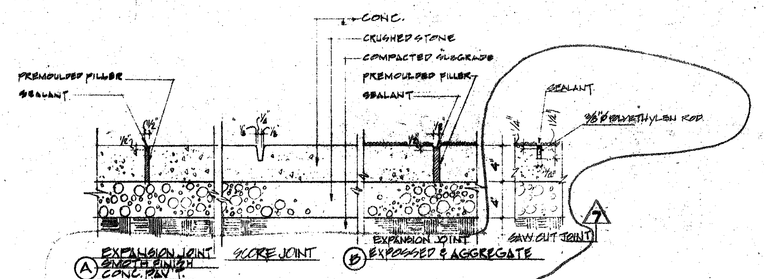

FURNITURE

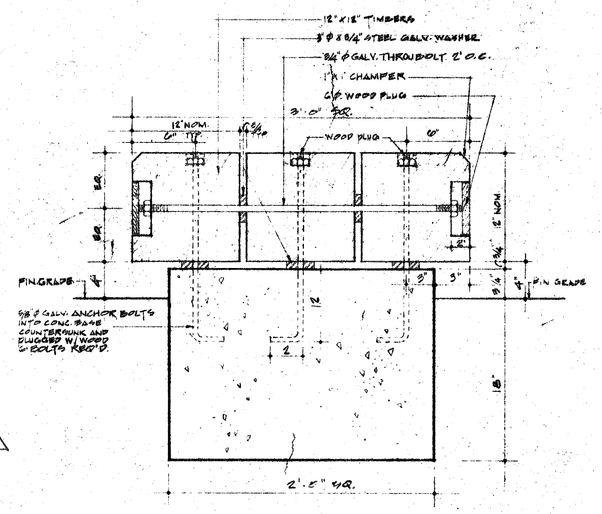

3 WOOD BENCH ON GRADE
SCALE: 1½"=1'-0"

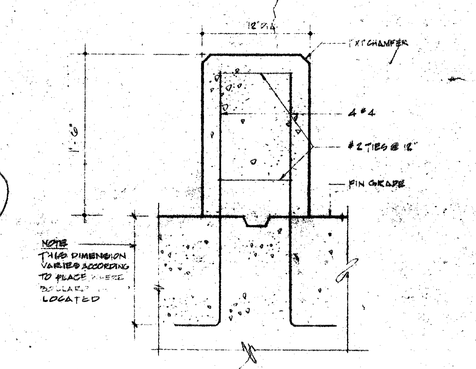

STAIRS

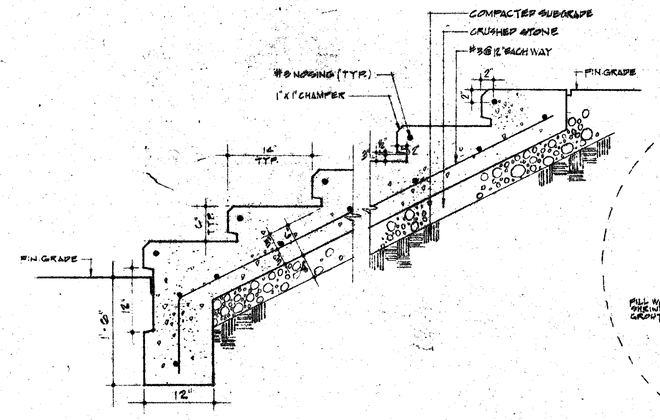

4 CONCRETE STAIR 6'x 14'
SCALE: 1"=1'-0"

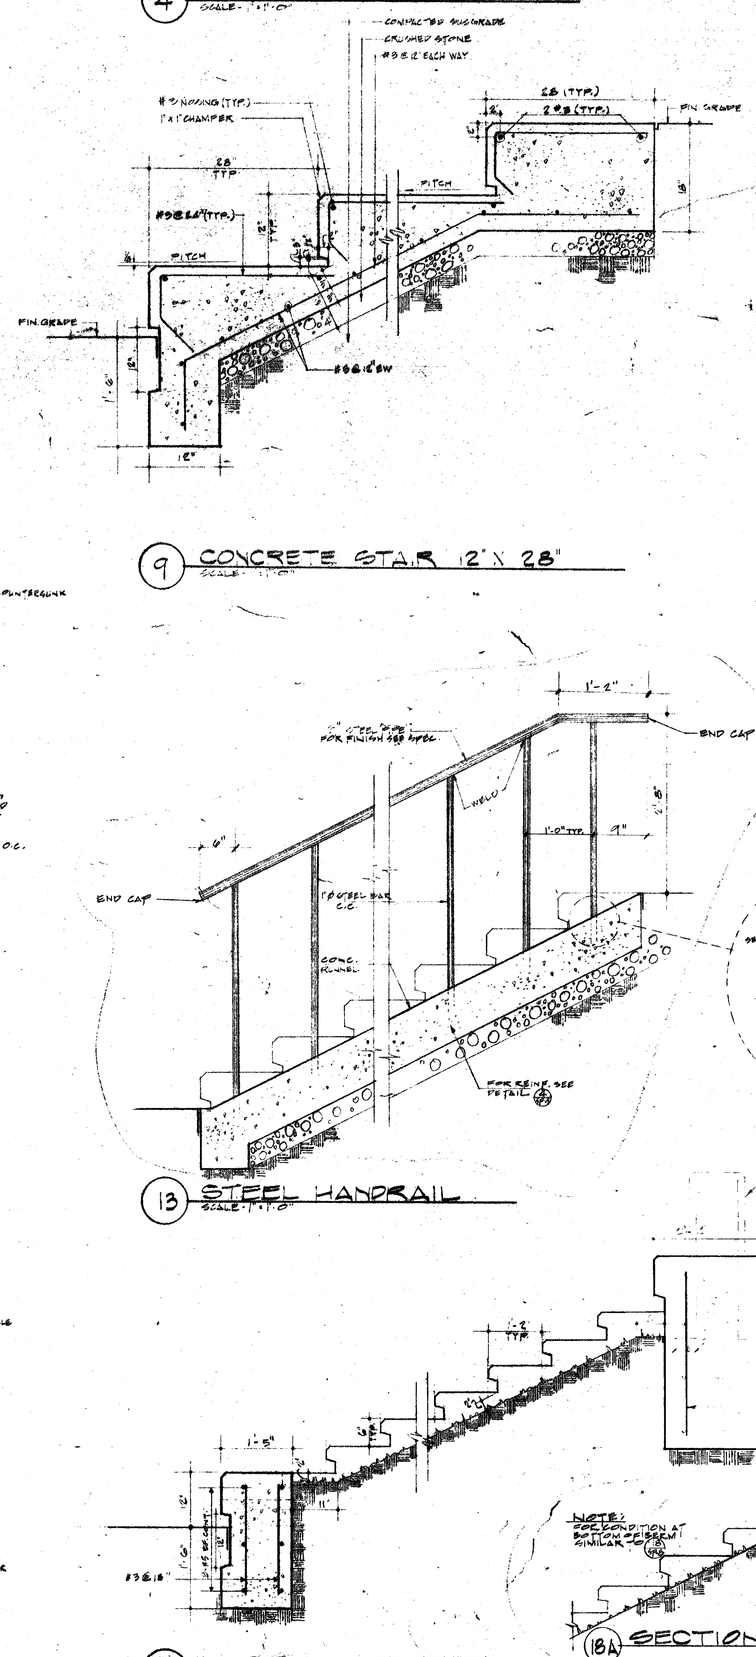

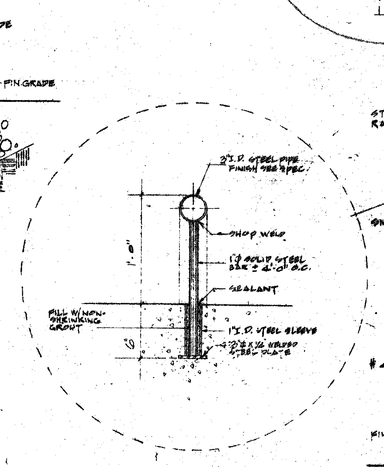

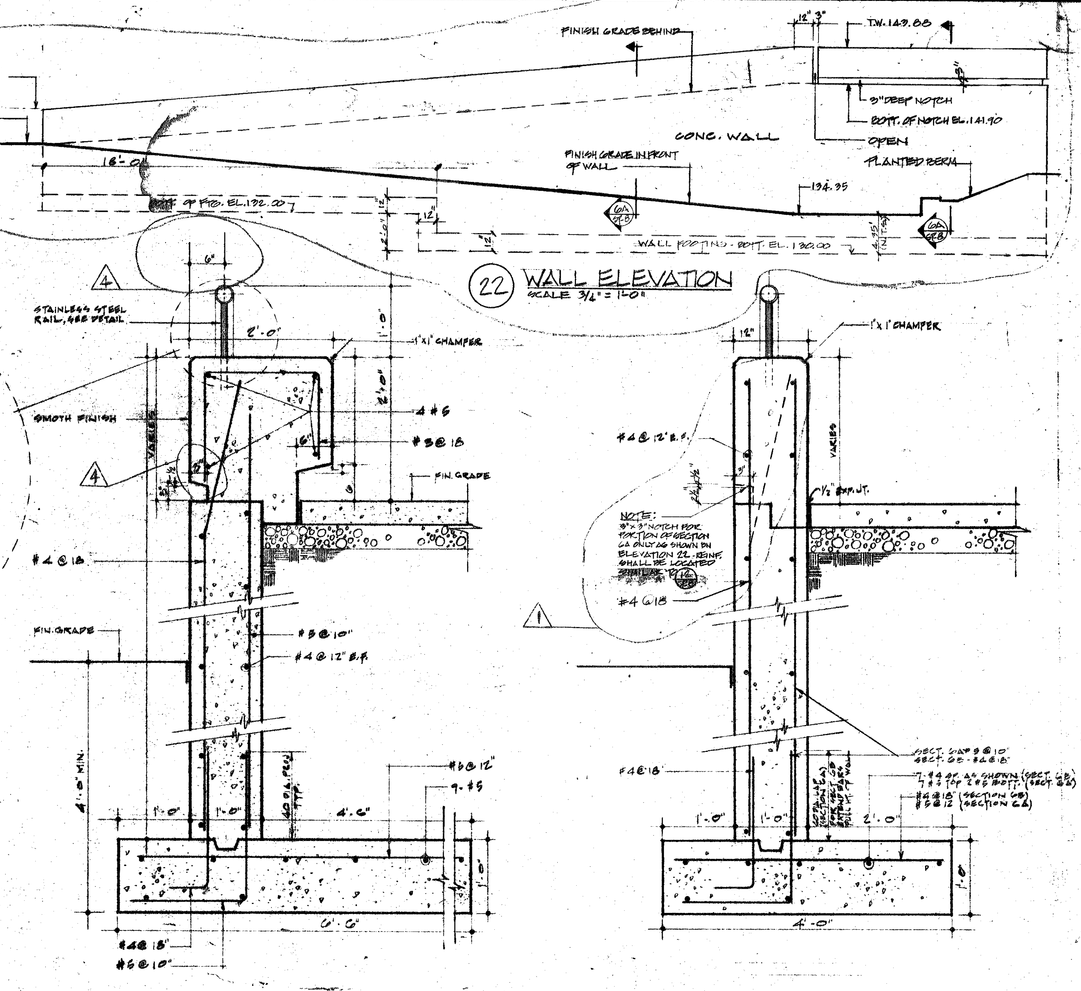

22 WALL ELEVATION
SCALE: 3/4"=1'-0"

5 CONCRETE WALL
SCALE: 1"=1'-0"

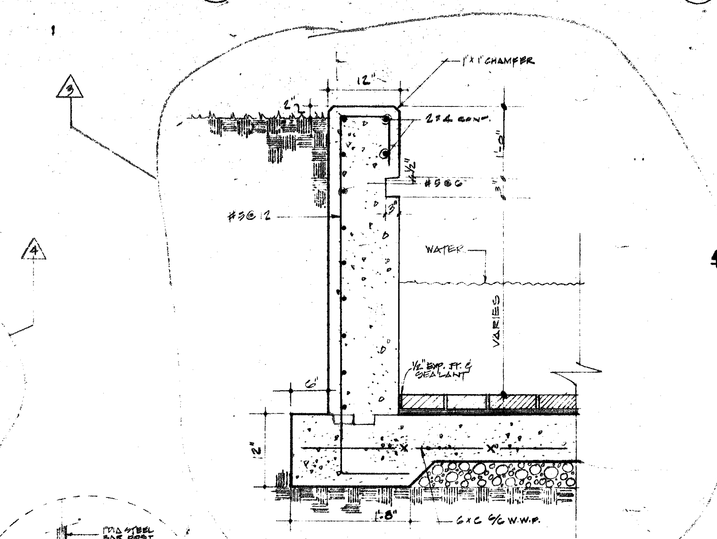

6A 6B CONCRETE WALL
SCALE: 1"=1'-0"

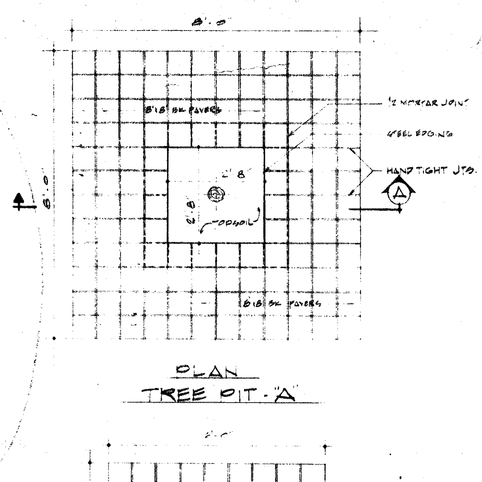

PLAN
TREE PIT-'A'

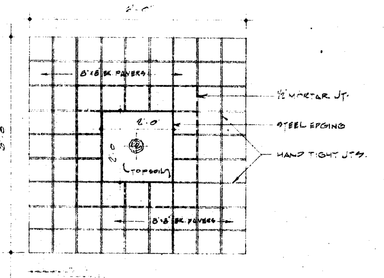

PLAN
TREE PIT-'B'

7 CONCRETE PAVEMENT ON GRADE
SCALE: 1"=1'-0"

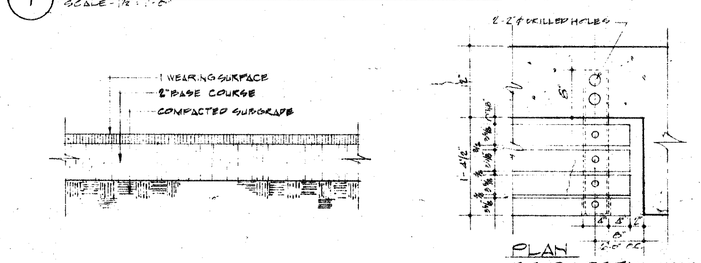

8 CONCRETE BOLLARD
SCALE: 1"=1'-0"

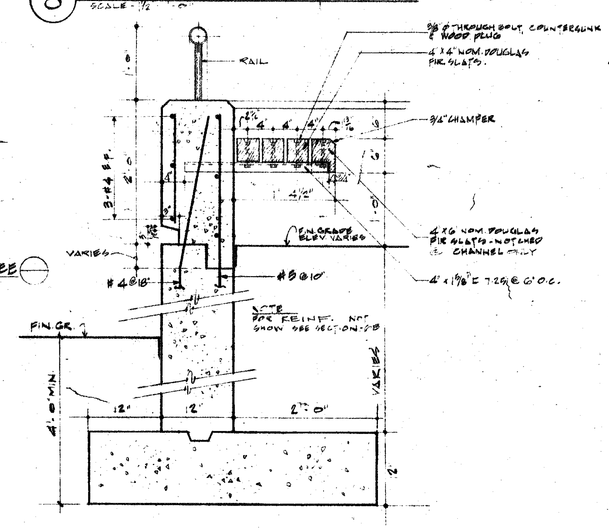

9 CONCRETE STAIR 12'x 28'
SCALE: 1"=1'-0"

13 STEEL HANDRAIL
SCALE: 1"=1'-0"

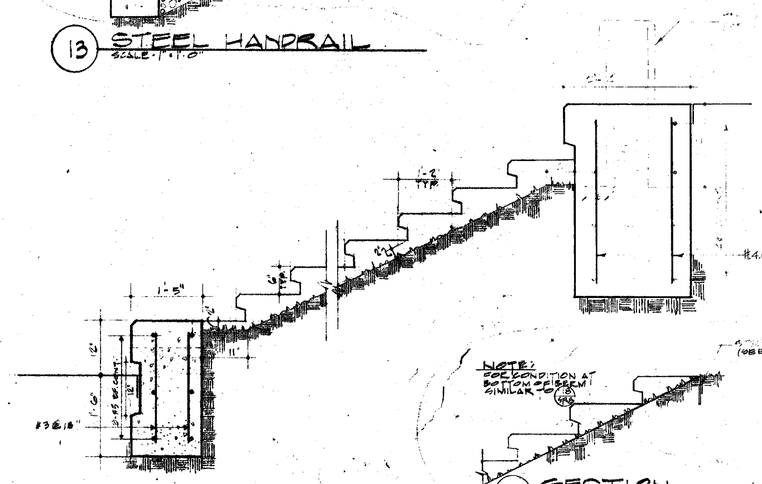

18 SECTION THRU BERM
SCALE: 1"=1'-0"

18A SECTION

14 CONCRETE WALL
SCALE: 1"=1'-0"

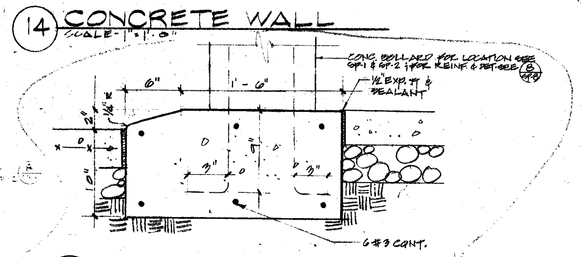

21 CONC CURB
SCALE 1½"=1'-0"

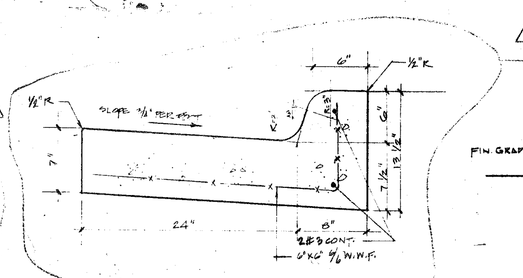

19 CONCRETE CURB & GUTTER
SCALE: 1"=1'-0"

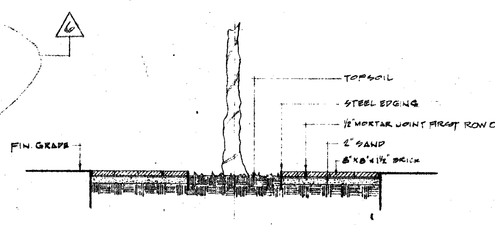

SECTION-'A'

20 TREE PIT BRICK PAV'T
SCALE: 1"=1'-0"

M. PAUL FRIEDBERG & ASSOCIATES
LANDSCAPE ARCHITECTURE
URBAN DESIGN
6 W. 82 ST. NEW YORK
N.Y. 10023

REGISTRATION IN MINNESOTA APPLIED FOR AND PENDING.

REVISIONS	DATE
ADDENDA #1	
1 ADDED WALL ELEVATION NO. 22 & REVISED DETAIL 6A SHOWING NOTCH	
2 ADDED CONC. CURB DETAIL No. 21	
3 REVISED DETAIL 14	
4 ADDED DIMENSION TO HANDRAIL DETAIL No. 19 & No. 5 AND DIMENSION AT NOTCH ON DETAIL No. 5	
5 ADDED DET. 18A SHOWING CONDITION @ TOP OF BERM	
6 REVISED DETAIL 19 WORK CONC. CURED	
7 ADDED CLASSIFICATION FOR CONCRETE MIX, PAVT & EXPOSED AGGREGATE CONC PAVT AS TYPE A & B RESPECTIVELY	
8 REVISED DET. #2	

CITY OF MINNEAPOLIS
MINNEAPOLIS, MINNESOTA

PEAVEY PARK PLAZA

MINNEAPOLIS, MINNESOTA

ASSOCIATE IN CHARGE	A.C. PEARSON
PROJECT ARCHITECT	JAY A. GOLD
DRAWN BY	CHECKED BY
SCALE AS SHOWN	DATE 5-21-74
TITLE	

SITE IMPROVEMENT DETAILS

JOB NUMBER 2073 DWG. No. SP-8

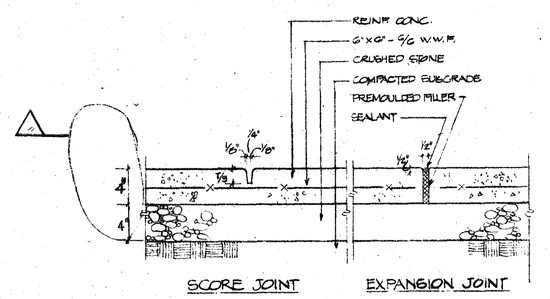

1 REINFORCED CONCRETE PAVEMENT
SCALE 1"=1'-0"

NOTE:
FOR STEEL PAVEMENT DETAIL
SEE 2, DWG SP-8

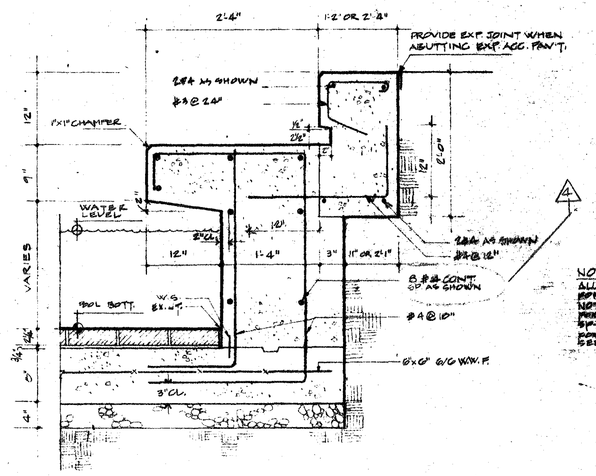
2'-6"
1'-2" OR 2'-3"
FIN GR.
WATER LEVEL
#4@12" EF
#5@12" EF
#5@12" EF

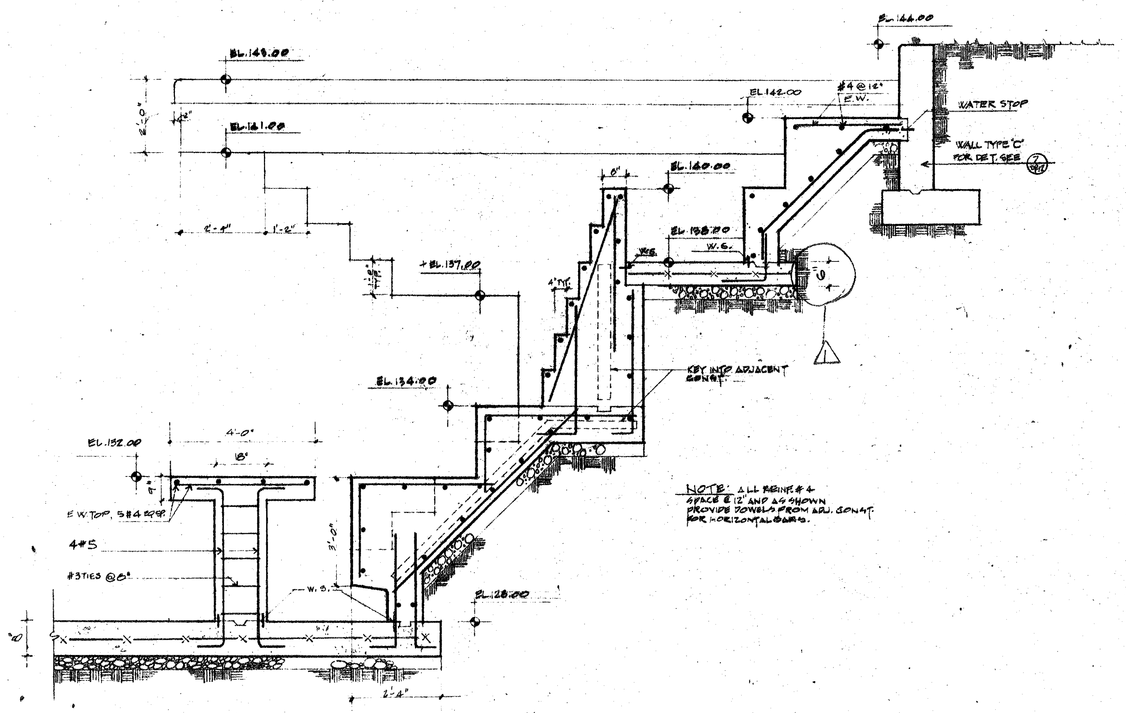

1 SECTION
SCALE: 1/8" = 1'-0"

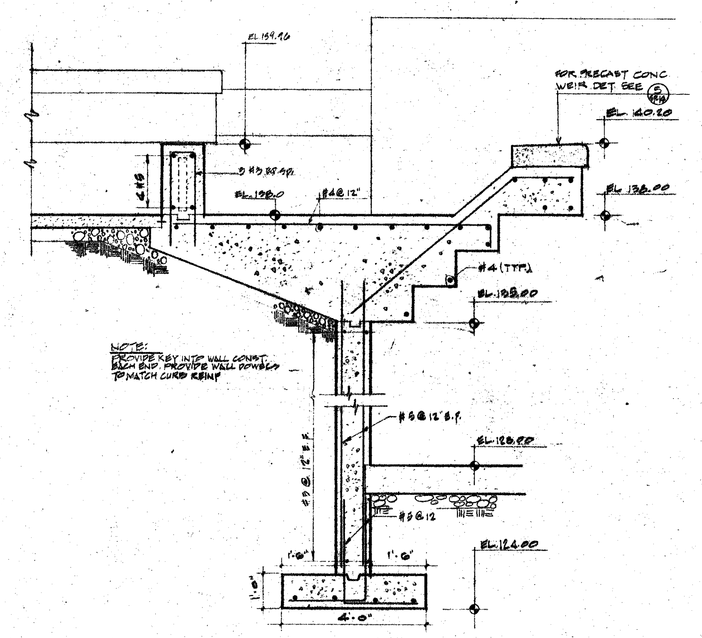

2 SECTION
SCALE: 1/8" = 1'-0"

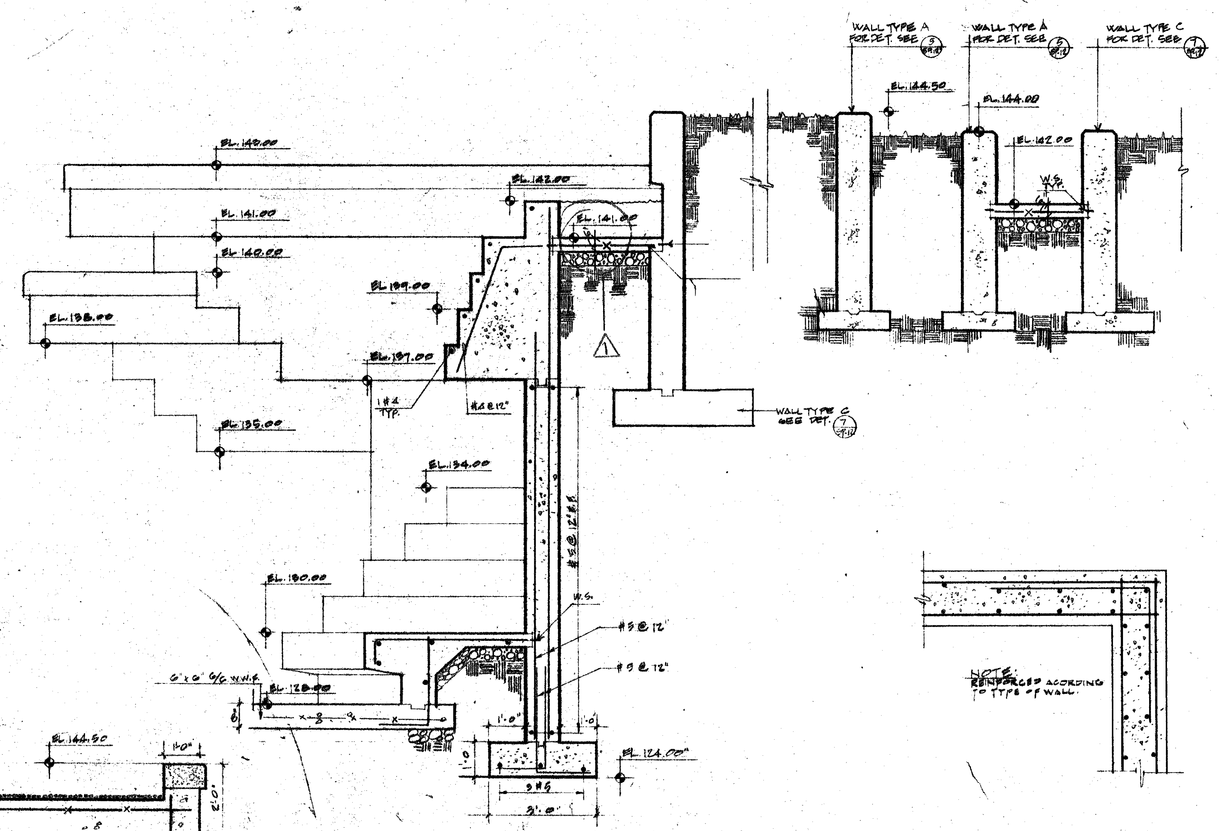

4 SECTION
SCALE: 1/2" = 1'-0"

7 TYP. REINF. DETAIL AT CORNERS
SCALE: 1 1/2" = 1'-0"

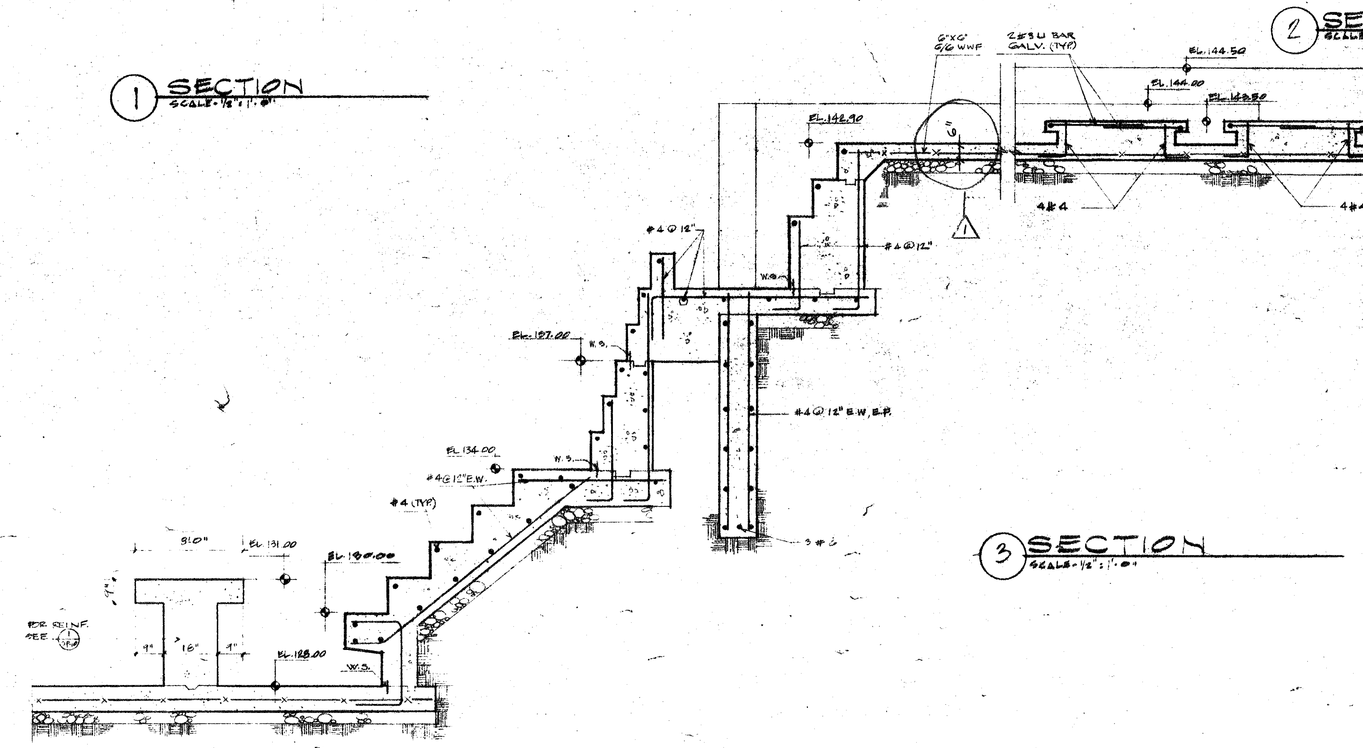

3 SECTION
SCALE: 1/2" = 1'-0"

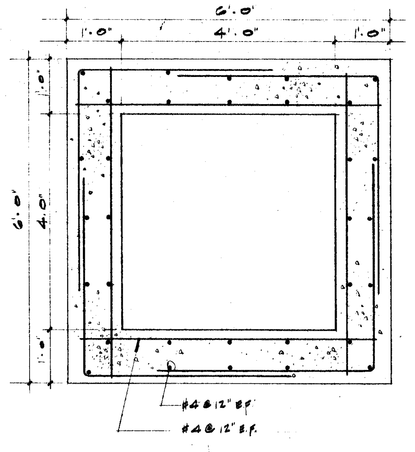

6 PLANTER TYPICAL SECTION - AA
SCALE: 1/4" = 1'-0"

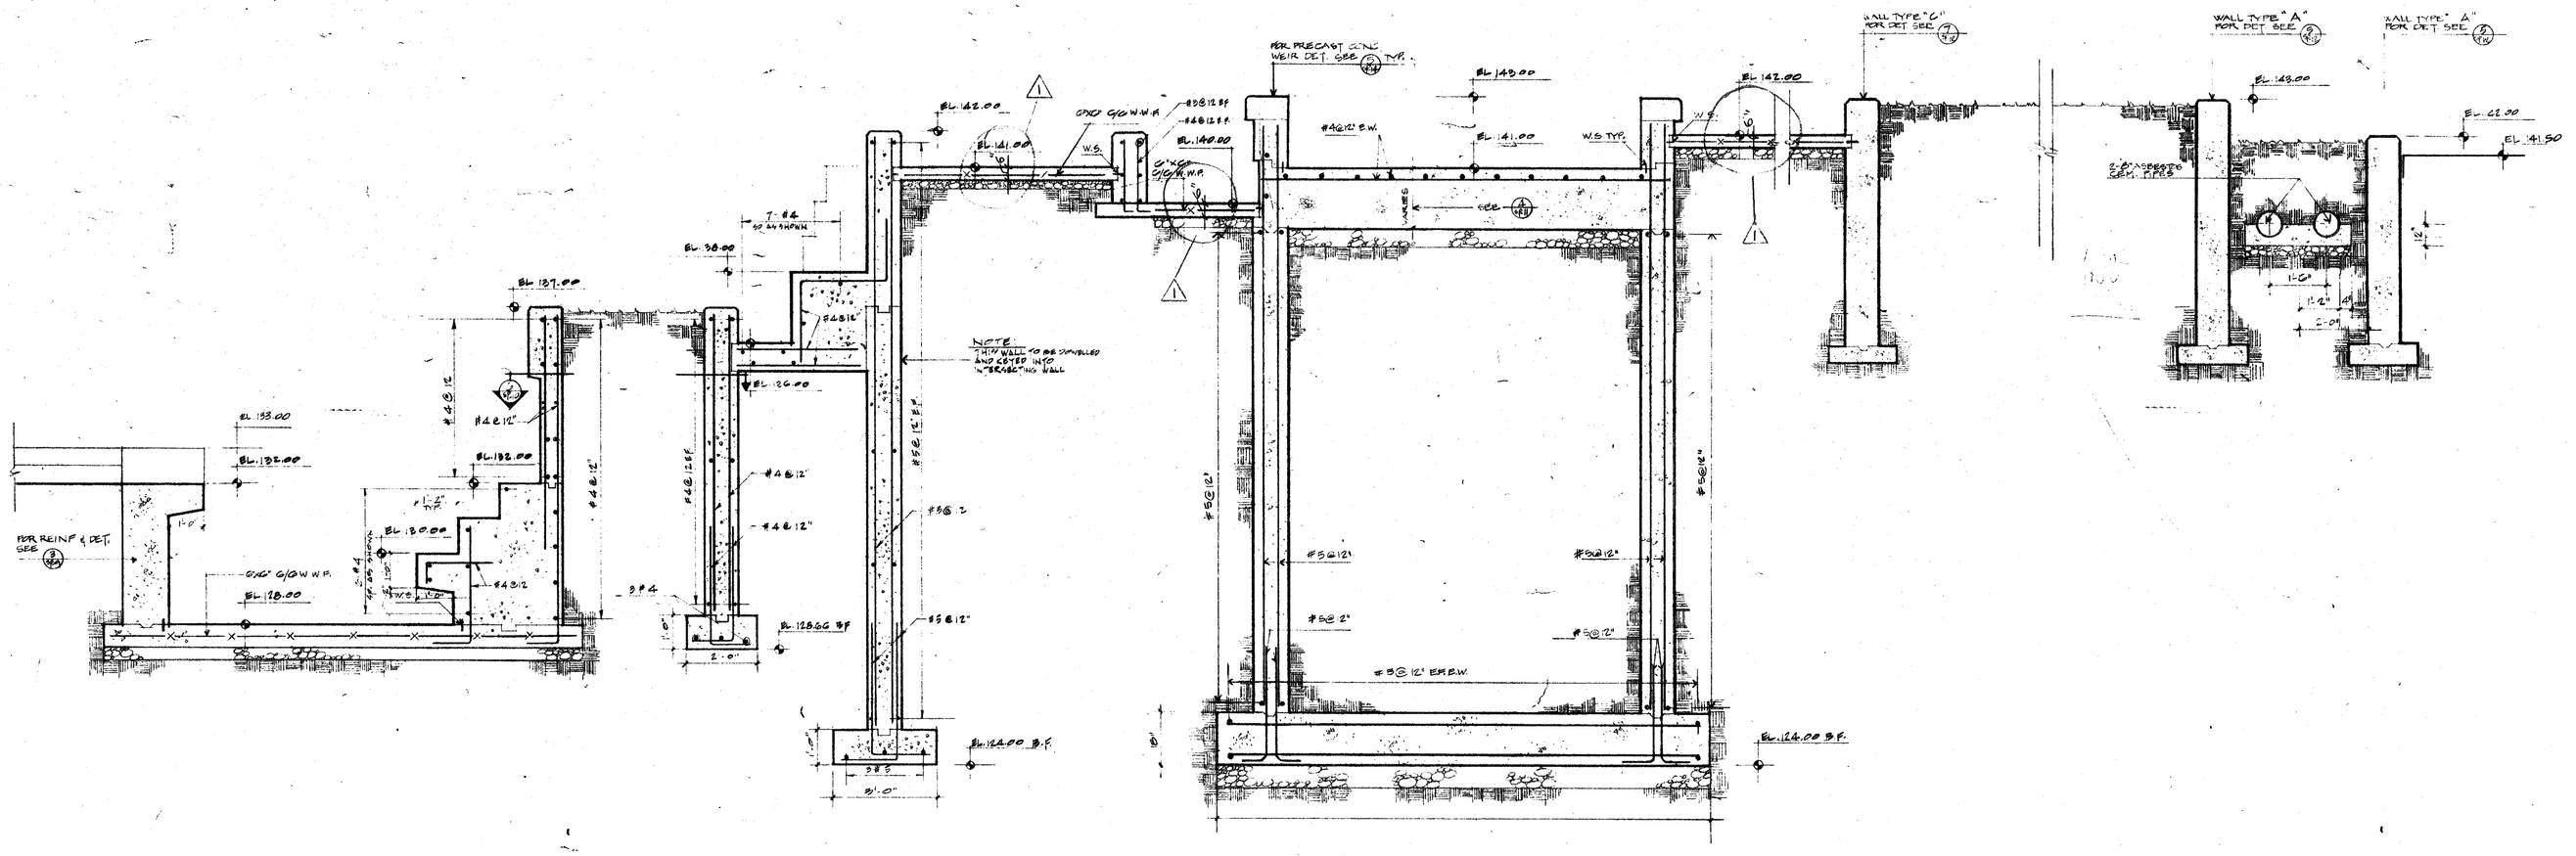

5 SECTION
SCALE: 1/2" = 1'-0"

M. PAUL FRIEDBERG & ASSOCIATES
LANDSCAPE ARCHITECTURE
URBAN DESIGN
41 W. 82 ST. NEW YORK
N.Y. 10023

REGISTERED IN MINNESOTA APPLIED FOR AND PENDING.

REVISIONS	DATE
ADDENDA #1	6-6-74
1 ADDED DIMENSION	

CITY OF MINNEAPOLIS
MINNEAPOLIS, MINNESOTA

PEAVEY PARK PLAZA

MINNEAPOLIS, MINNESOTA

ASSOCIATE IN CHARGE	A.C. PEARSON
PROJECT ARCHITECT	JAY A. GOLD
DRAWN BY	CHECKED BY
SCALE AS SHOWN	DATE 5-21-74
TITLE	

SITE IMPROVEMENT DETAILS

MPP JOB #	DWG. No.
2073	SP-10

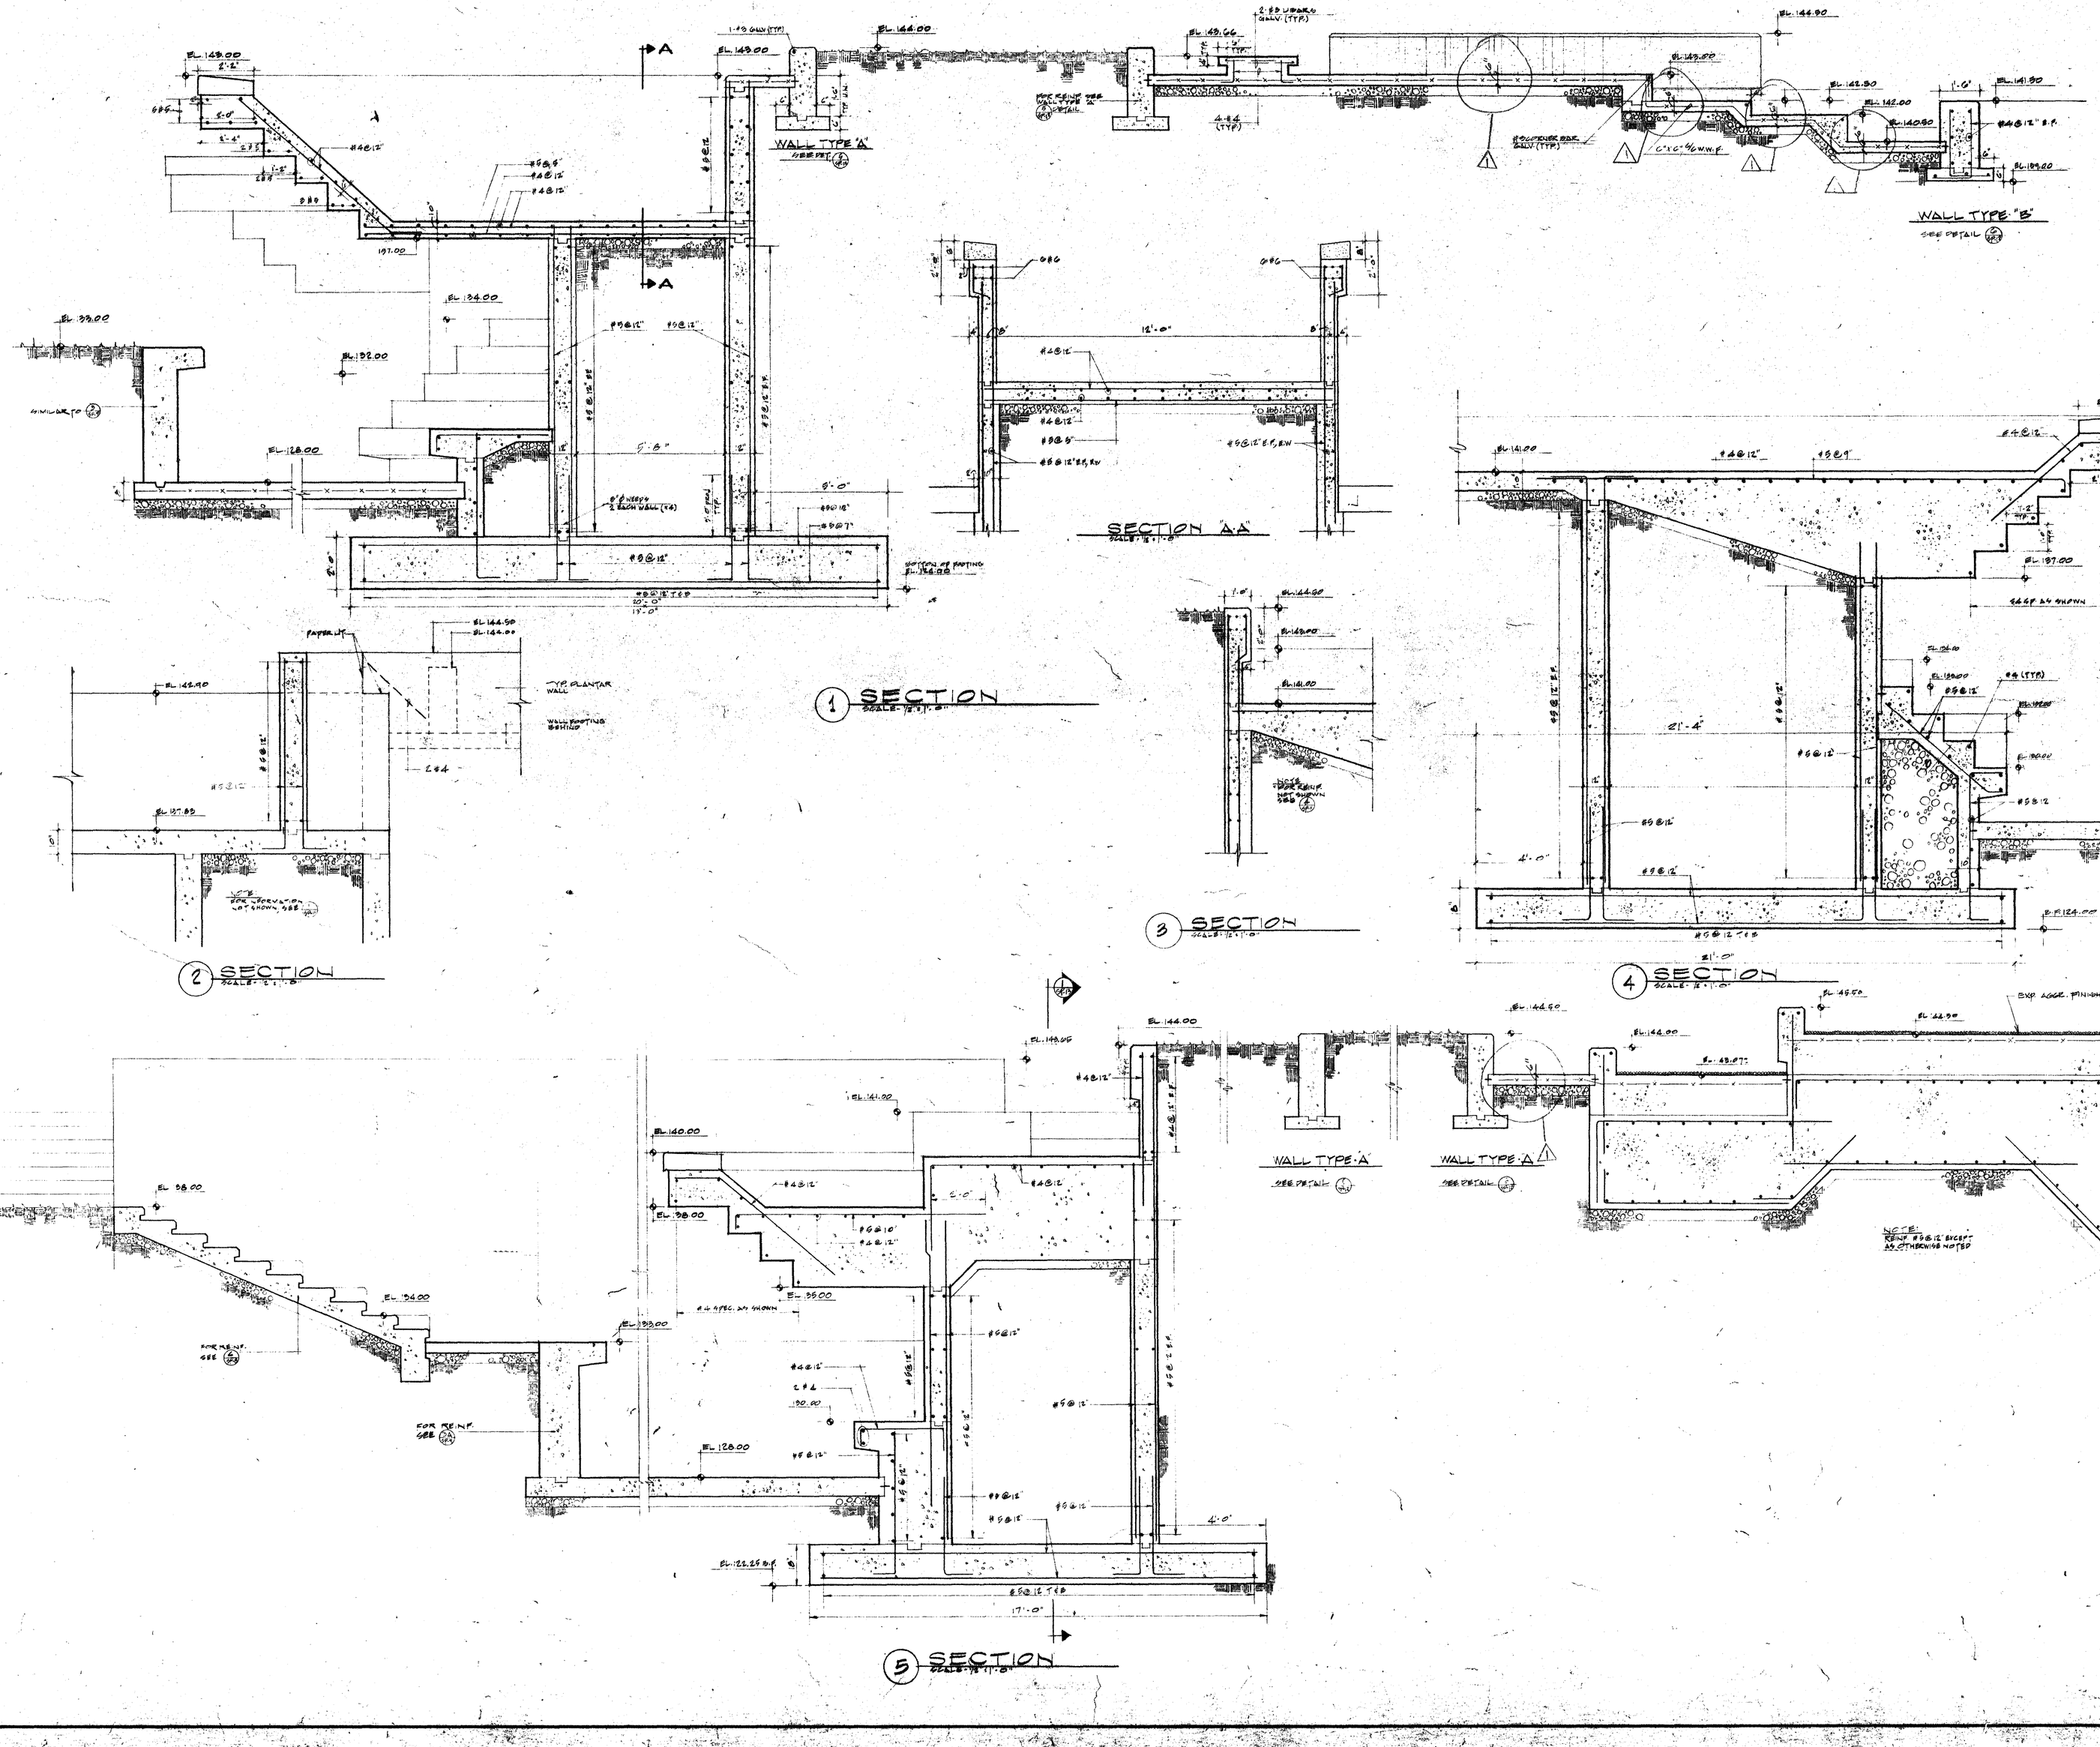

M. PAUL FRIEDBERG & ASSOCIATES

LANDSCAPE ARCHITECTURE
URBAN DESIGN

4 W. 62 ST. NEW YORK
N.Y. 10023

REGISTRATION IN MINNESOTA APPLIED FOR AND PENDING.

REVISIONS	DATE
ADDENDA #1	6-6-74
⚠ ADDED DIMENSION	

CITY OF MINNEAPOLIS
MINNEAPOLIS, , MINNESOTA

PEAVEY PARK PLAZA

MINNEAPOLIS, MINNESOTA

ASSOCIATE IN CHARGE	A.C. PEARSON
PROJECT ARCHITECT	JAY A. GOLD
DRAWN BY	CHECKED BY
SCALE AS SHOWN	DATE 5-21-74

TITLE

SITE IMPROVEMENT DETAILS

MPF JOB # 2073

DWG. No. SP-11

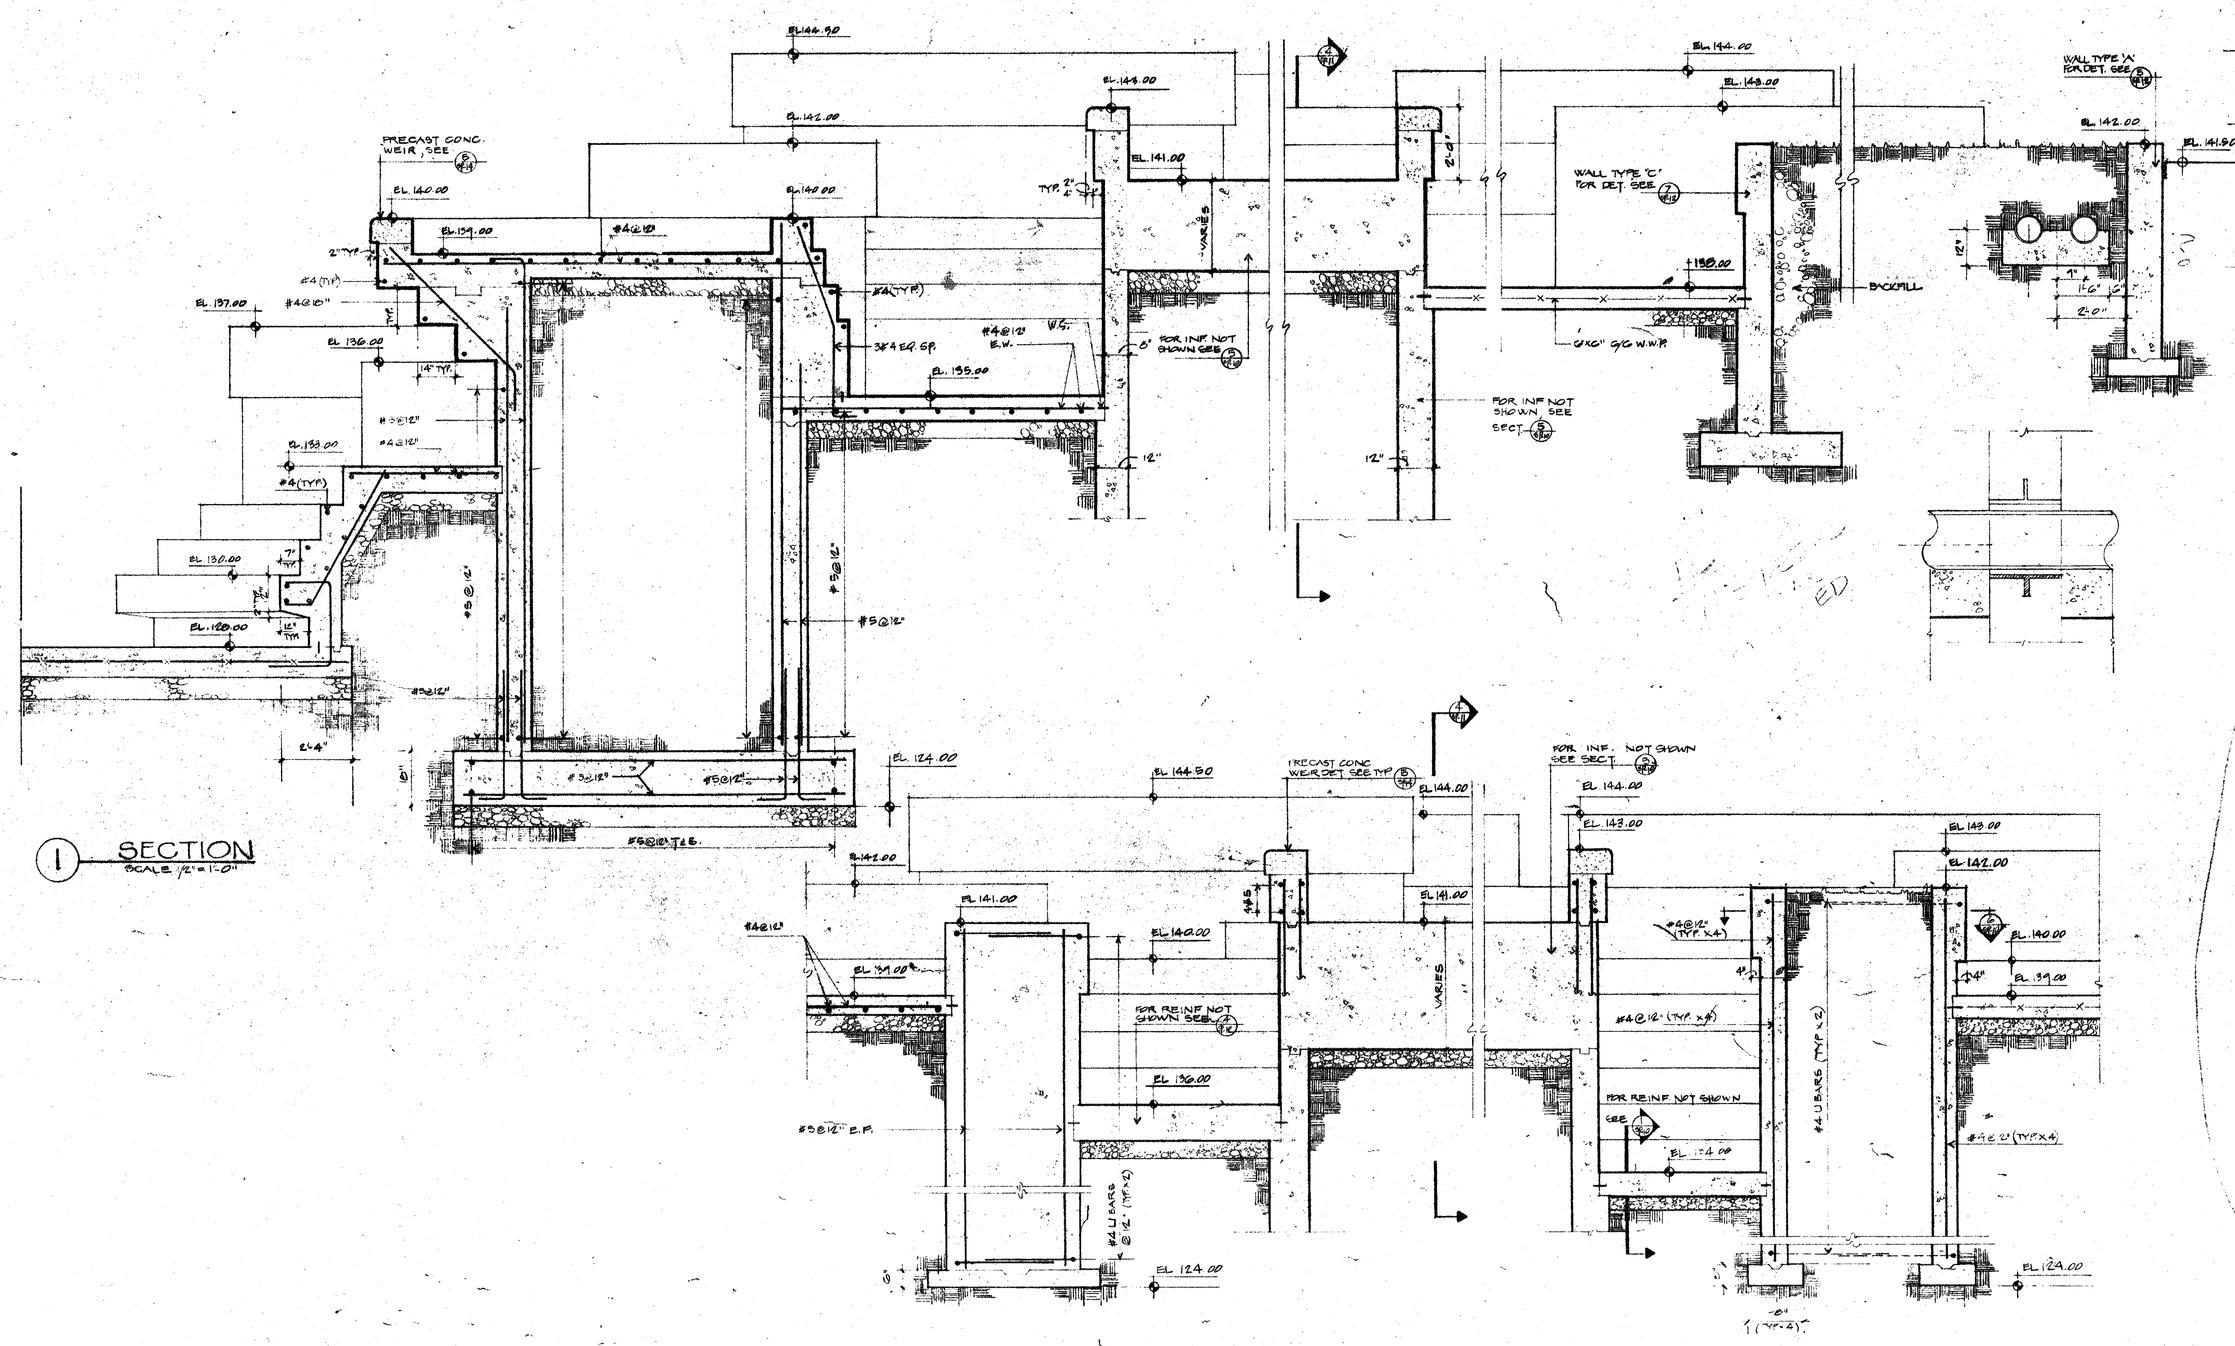
PRECAST CONC. WEIR, SEE
EL 146.50
EL 144.00
EL 142.00
EL 141.00
EL 140.00
EL 139.00
EL 137.00
EL 136.00
EL 135.00
EL 133.00
EL 132.00
EL 130.00
#4@12"
#5@12"
#6@12"
#6@12" E.F.
#6@12" E.W.
#5@12" E.F.
#4@12" E.F.
#4@12" E.W.
#4(TYP.)
#4@10"
#6(TYP.)
#5@12"
#3@12"

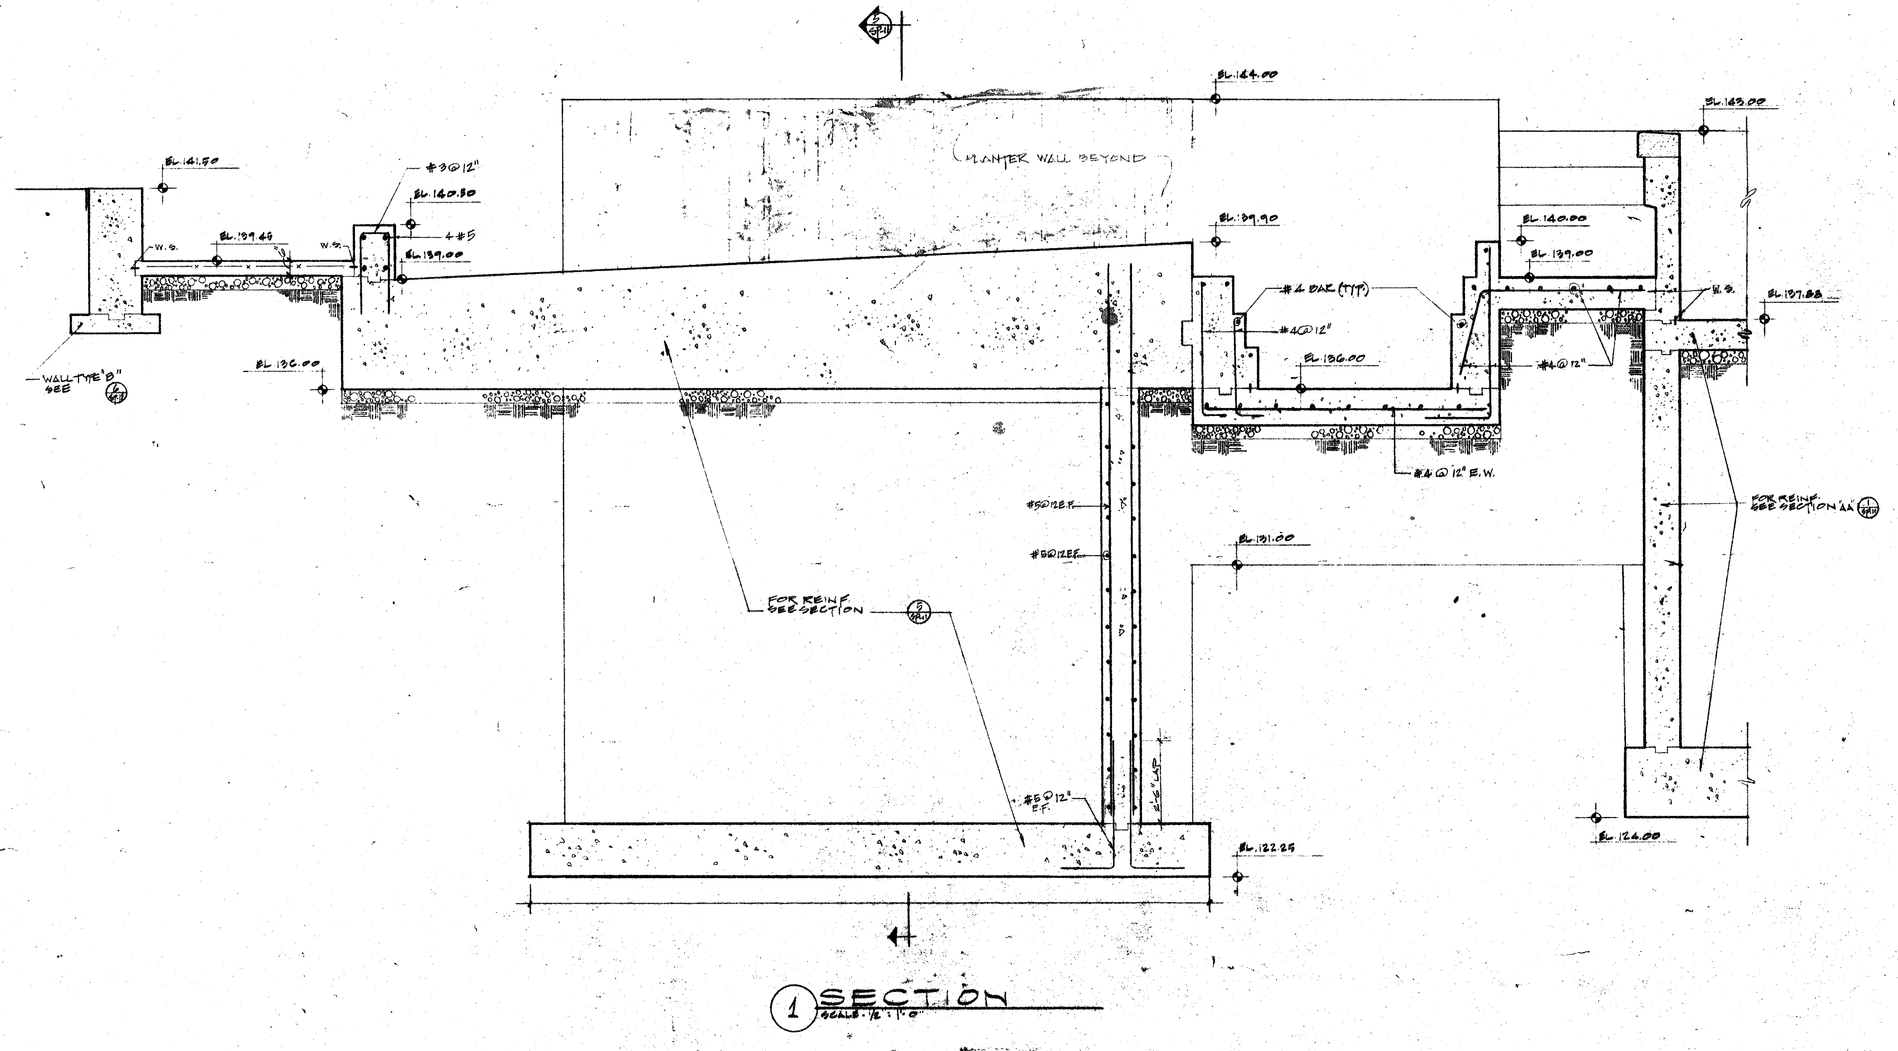

1 SECTION
SCALE: 1/2" = 1'-0"

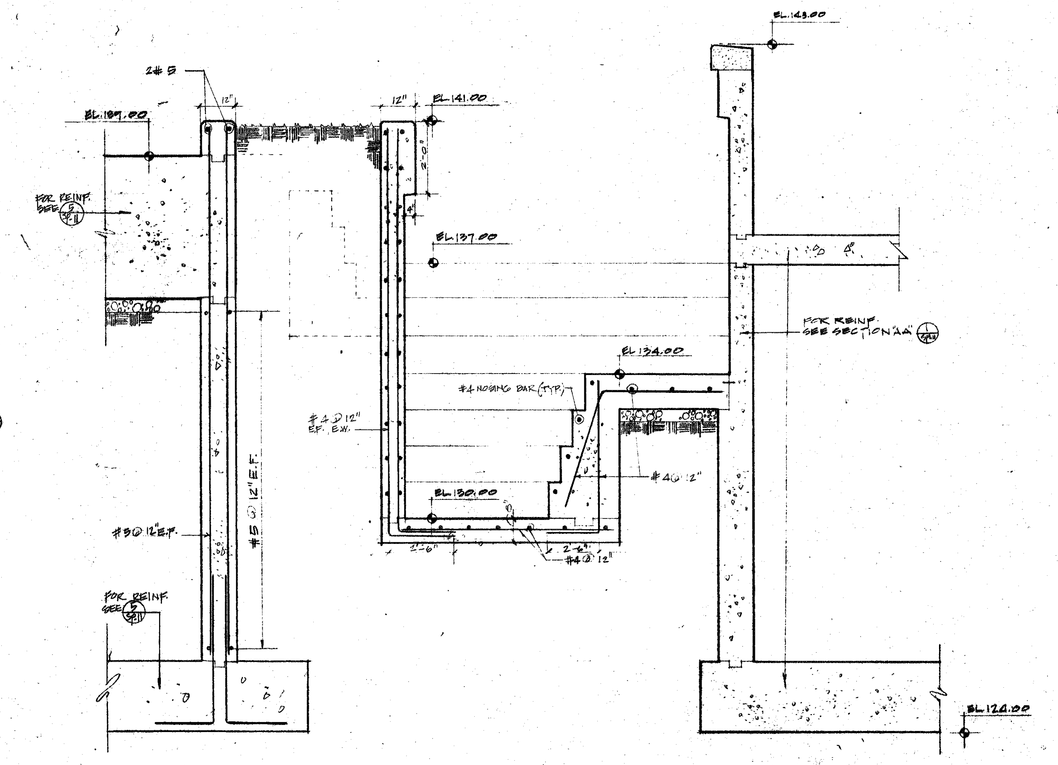

2 SECTION
SCALE: 1/2" = 1'-0"

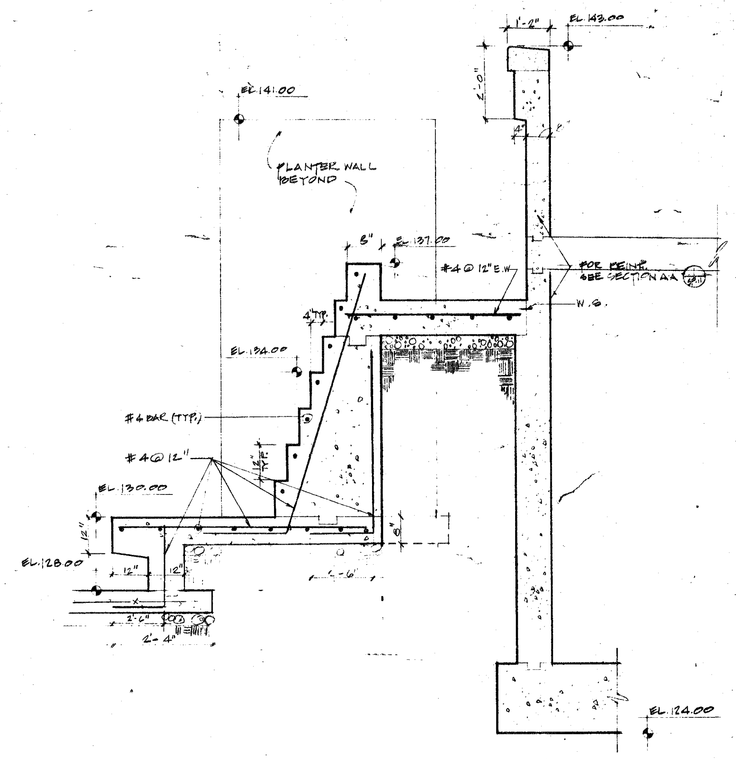

3 SECTION
SCALE: 1/2" = 1'-0"

M. PAUL FRIEDBERG & ASSOCIATES
LANDSCAPE ARCHITECTURE
URBAN DESIGN
4 W. 62 ST. NEW YORK
N.Y. 10023

STATE OF NEW YORK — LICENSED — M. PAUL FRIEDBERG — LICENSED PROFESSIONAL ENGINEER

REGISTRATION IN MINNESOTA APPLIED FOR AND PENDING.

REVISIONS	DATE
ADDENDA #2	6-17-74
1 REVISED SECTION 1, 2 & 3 ADDING DIMENSIONS & REINF.	

CITY OF MINNEAPOLIS
MINNEAPOLIS., MINNESOTA

PEAVEY PARK PLAZA

MINNEAPOLIS, MINNESOTA

ASSOCIATE IN CHARGE	A.C. PEARSON
PROJECT ARCHITECT	JAY A. GOLD
DRAWN BY MR	CHECKED BY MSP
SCALE AS SHOWN	DATE 5-21-74

TITLE

SITE IMPROVEMENT DETAILS.

MPF JOB # | DWG. No. SP.13

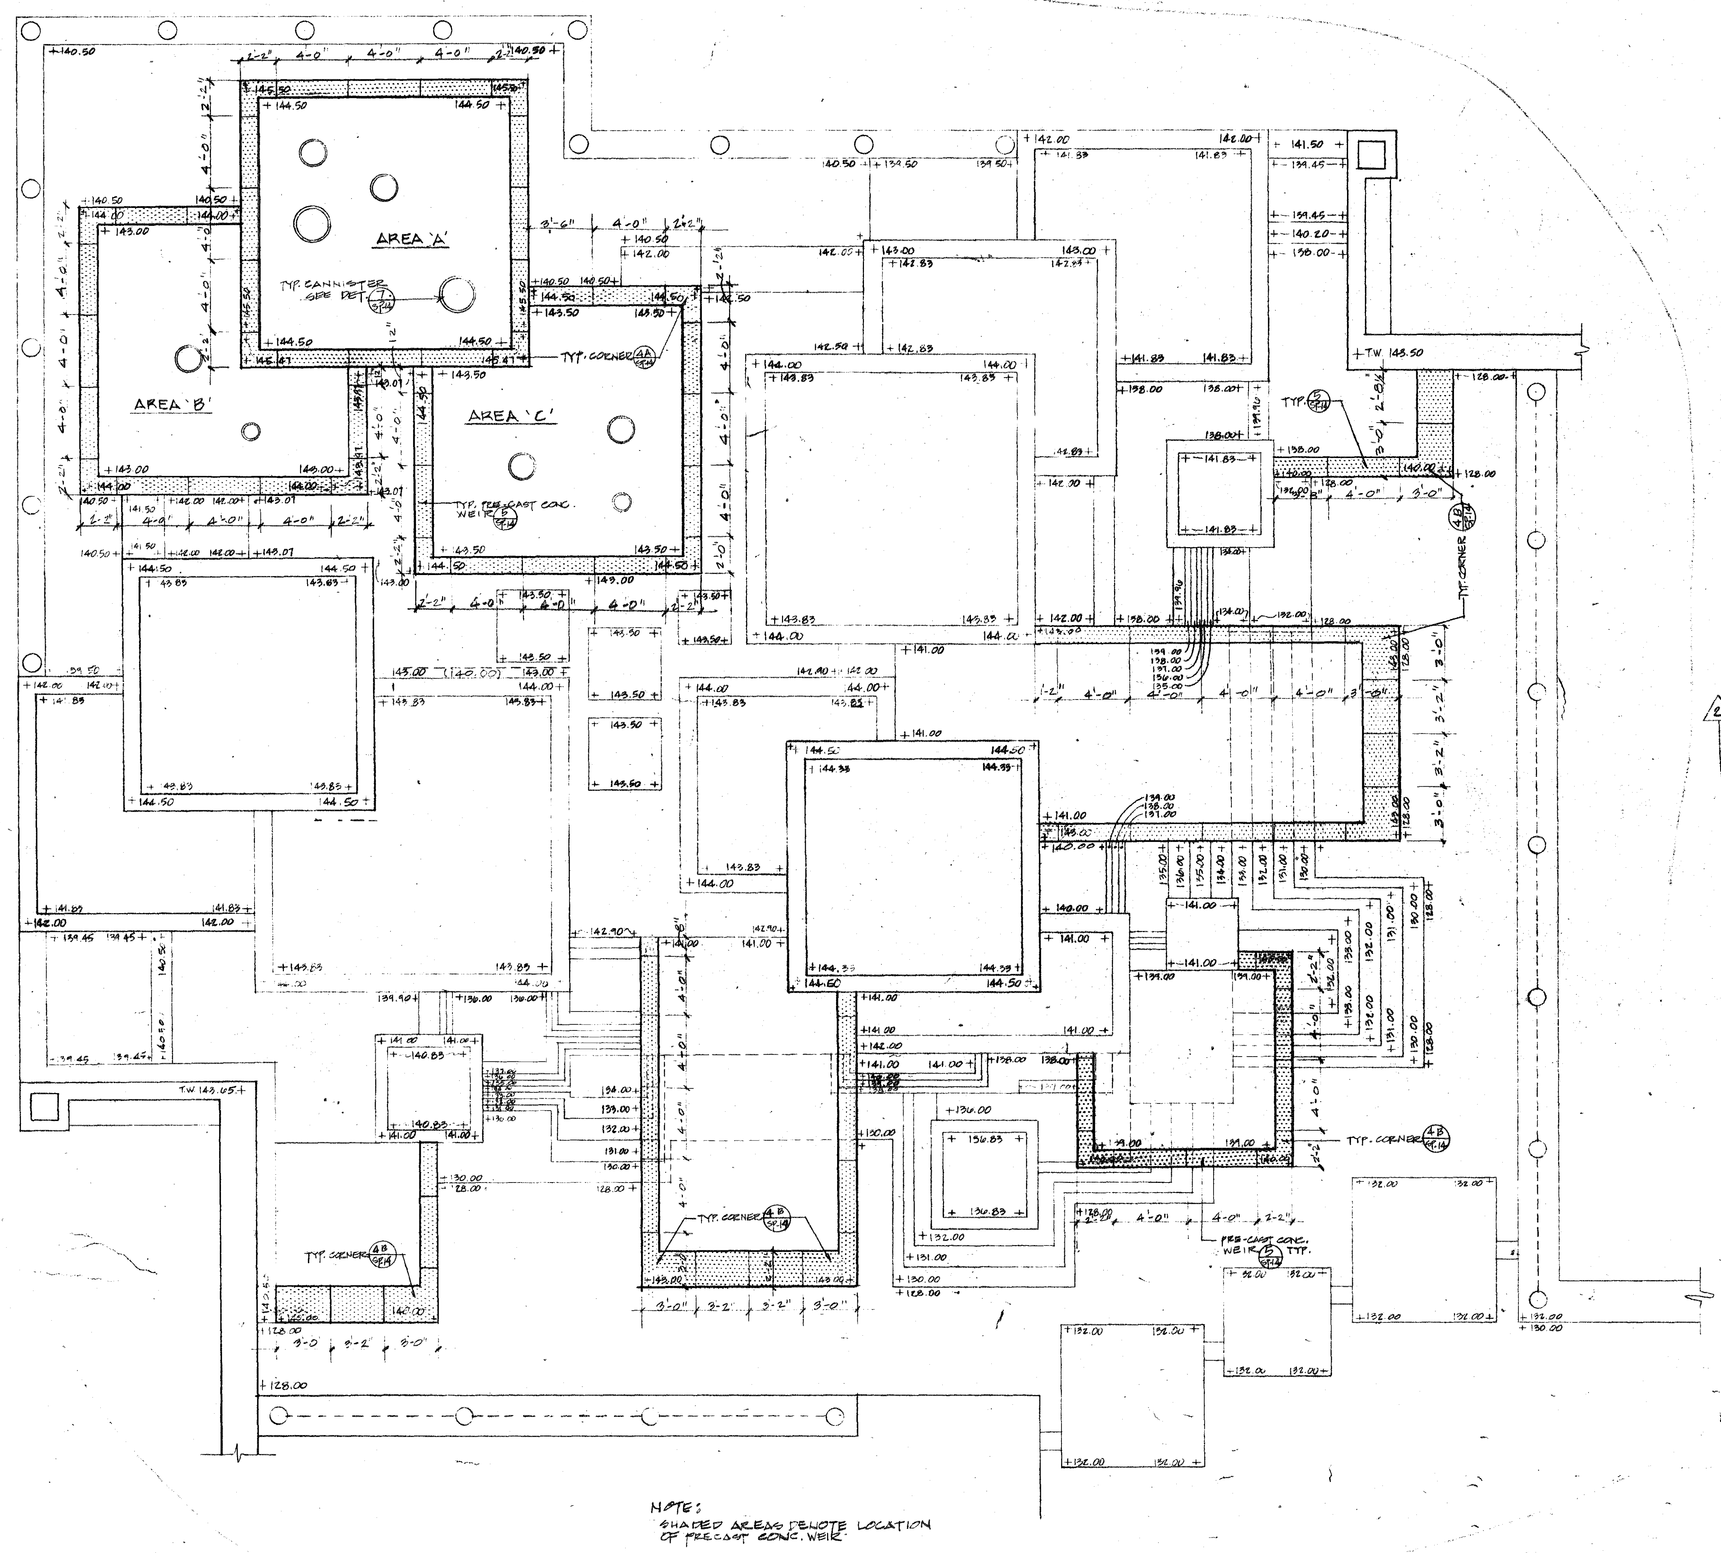

1 UPPER FOUNTAIN PLAN
SCALE: 1/4" = 1'-0"

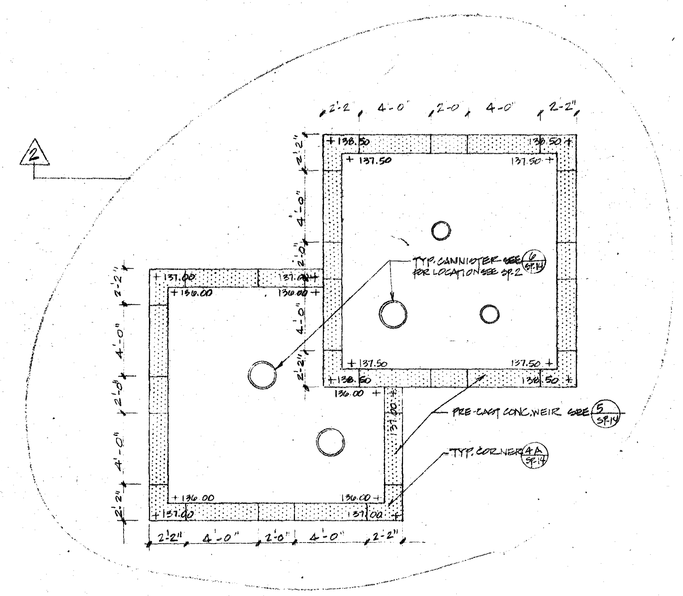

2 EAST FOUNTAIN PLAN
SCALE: 1/4" = 1'-0"

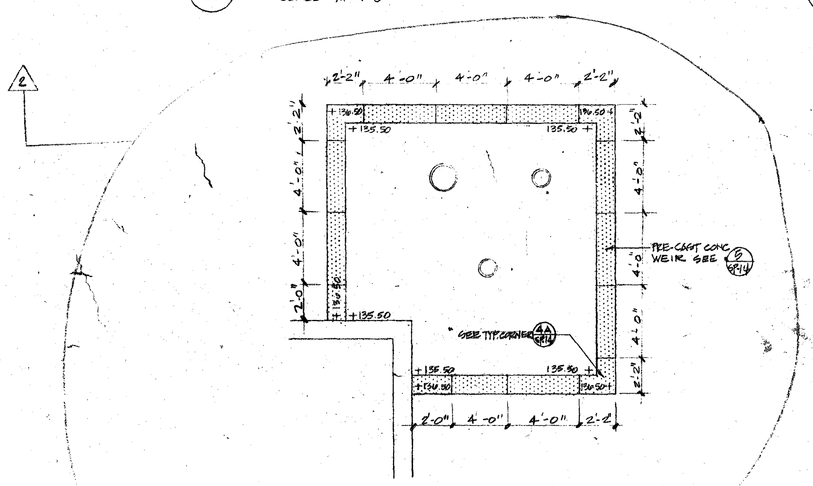

3 LOWER FOUNTAIN PLAN
SCALE: 1/4" = 1'-0"

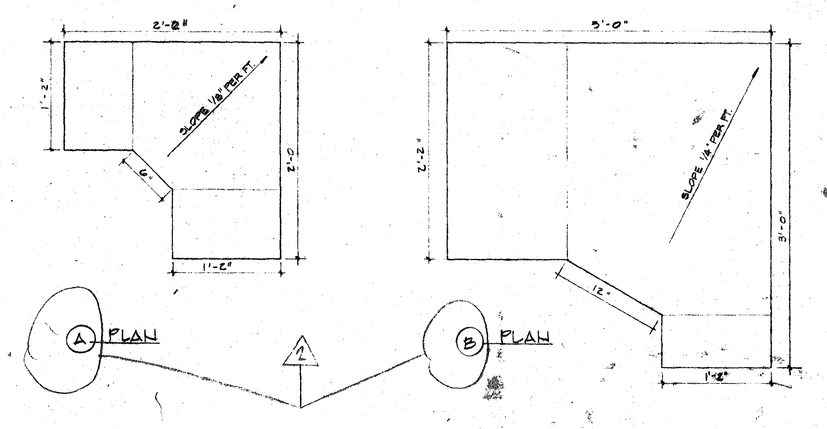

4 PRE-CAST CONC. WEIR CORNER SECTIONS
SCALE: 1½" = 1'-0"

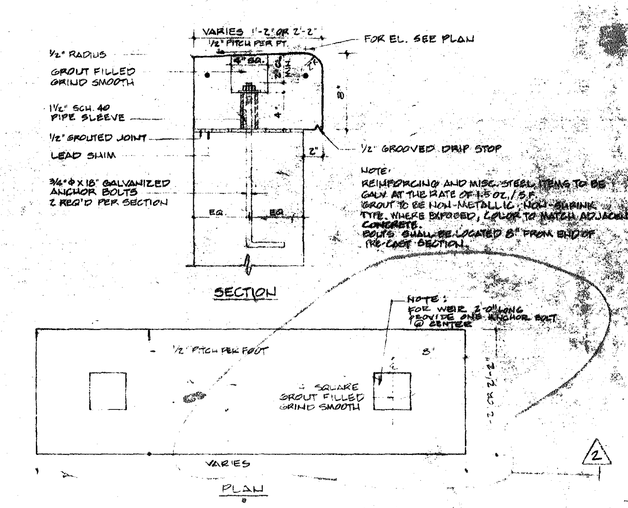

5 PRE-CAST CONCRETE WEIR DETAILS
SCALE: 1½" = 1'-0"

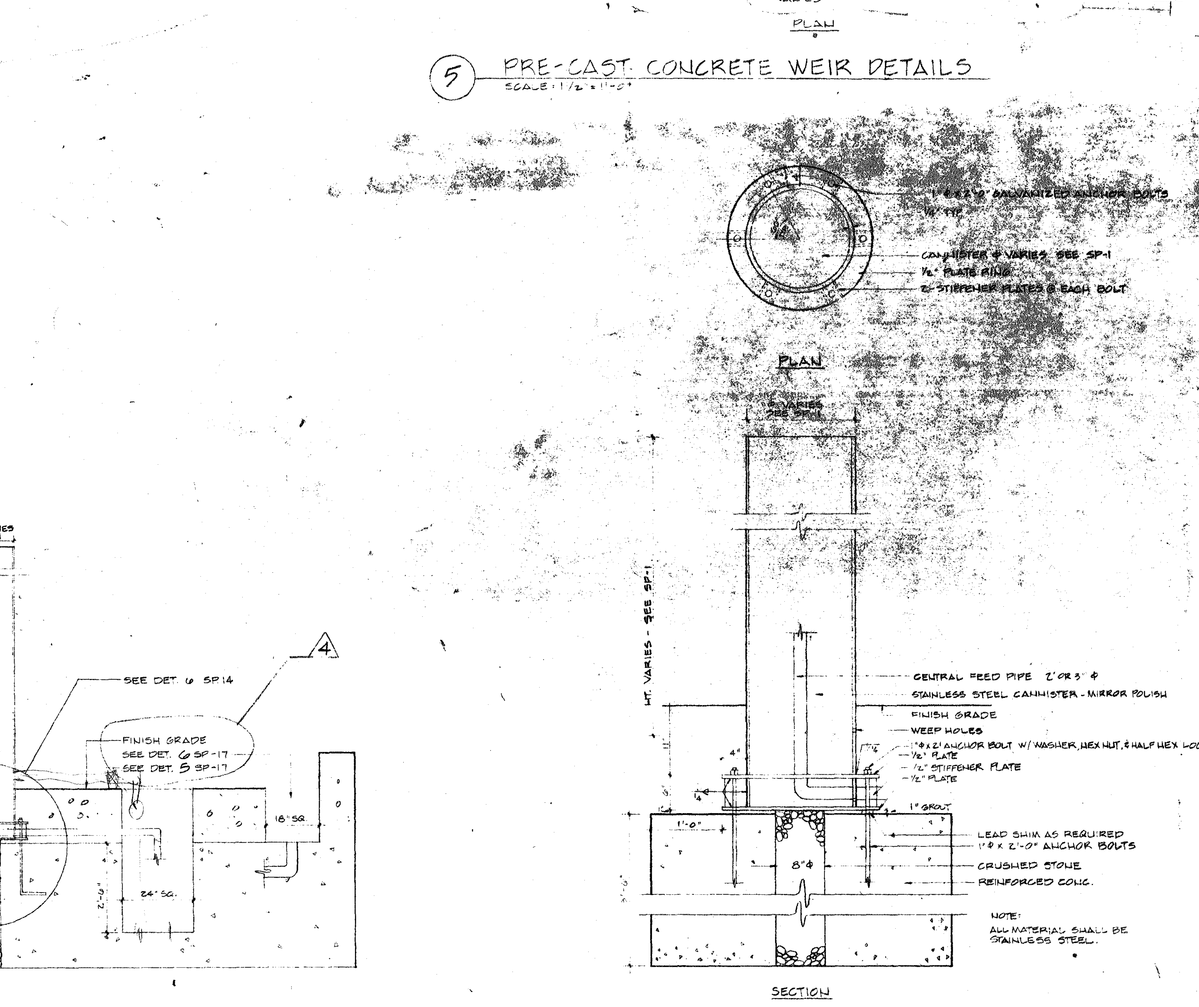

6 STAINLESS STEEL CANNISTER DETAIL
SCALE: 1"= 1'-0"

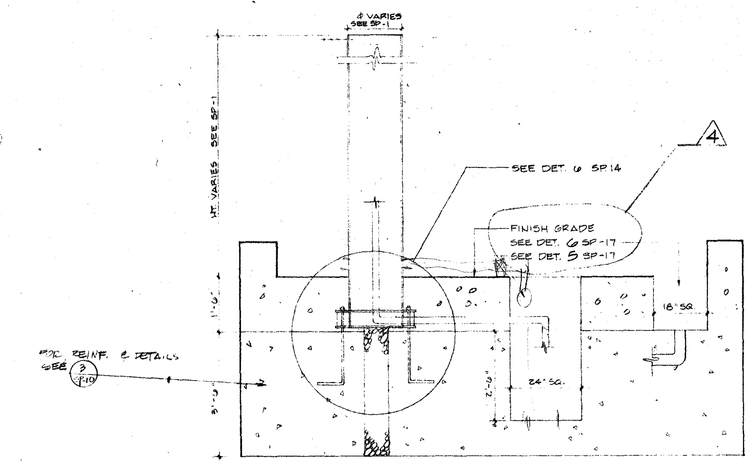

7 TYPICAL SECTION @ FOUNTAIN
SCALE: 1/2"=1'-0"

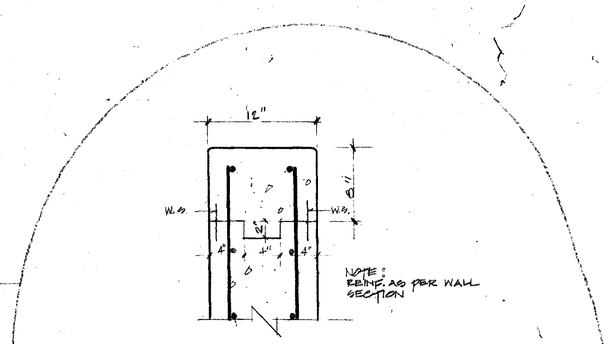

8 CAST IN PLACE CONCRETE WEIR
DEDUCT ALTERNATE # 8

M. PAUL FRIEDBERG & ASSOCIATES
LANDSCAPE ARCHITECTURE
URBAN DESIGN
4 W. 62 ST. NEW YORK
N.Y. 10023

REGISTRATION IN MINNESOTA APPLIED FOR AND PENDING

REVISIONS	DATE
ADDENDA # 1	
1 ADDED DETAIL No. 4 FOR CAST IN PLACE CONC. WEIR - DEDUCT ALTERNATE No. 8	
2 DIMENSIONS & INFORMATION ADDED TO DET. 1, 2, 3, & 5	
3 ADDED 4 & 4 TO DET. 4	
4 ADDED INFORMATION TO DET. 7	

CITY OF MINNEAPOLIS
MINNEAPOLIS, MINNESOTA

PEAVEY PARK PLAZA

MINNEAPOLIS, MINNESOTA

ASSOCIATE IN CHARGE	A.C. PEARSON
PROJECT ARCHITECT	JAY A. GOLD
DRAWN BY	CHECKED BY
SCALE AS SHOWN	DATE 5-21-74

TITLE

FOUNTAIN WEIR PLANS AND DETAILS

MPF JOB #	DWG. No.
2073	SP-14

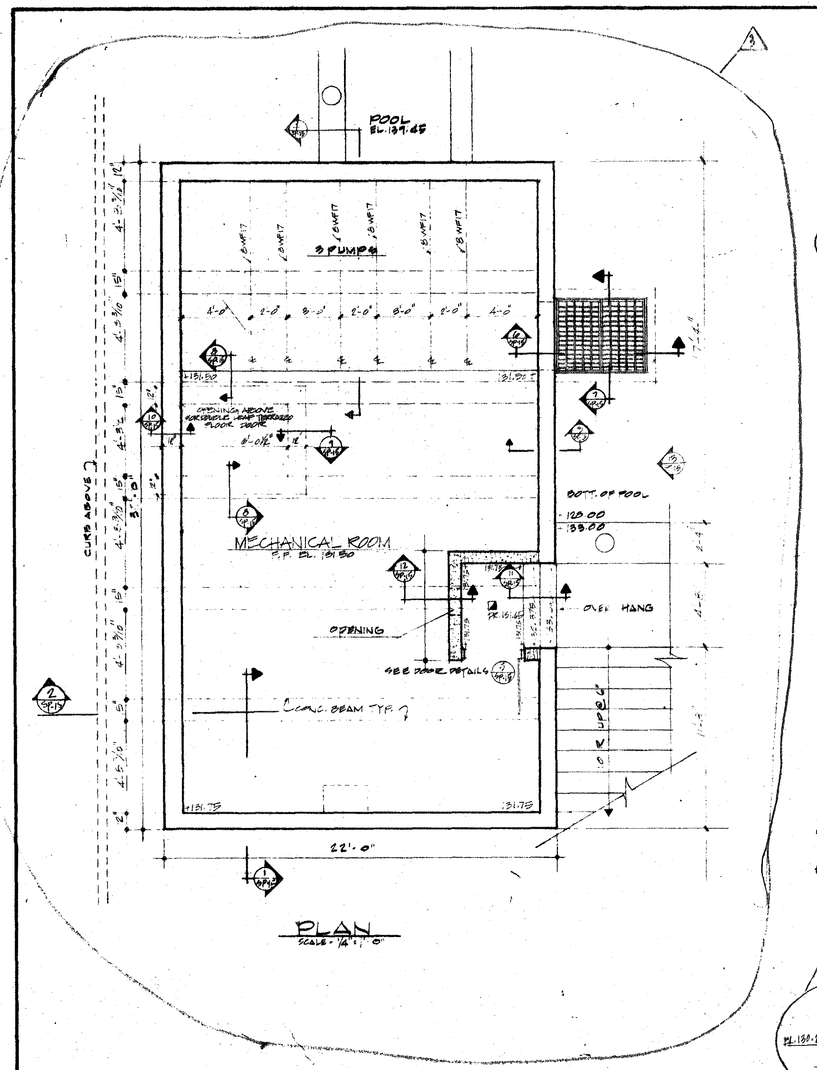

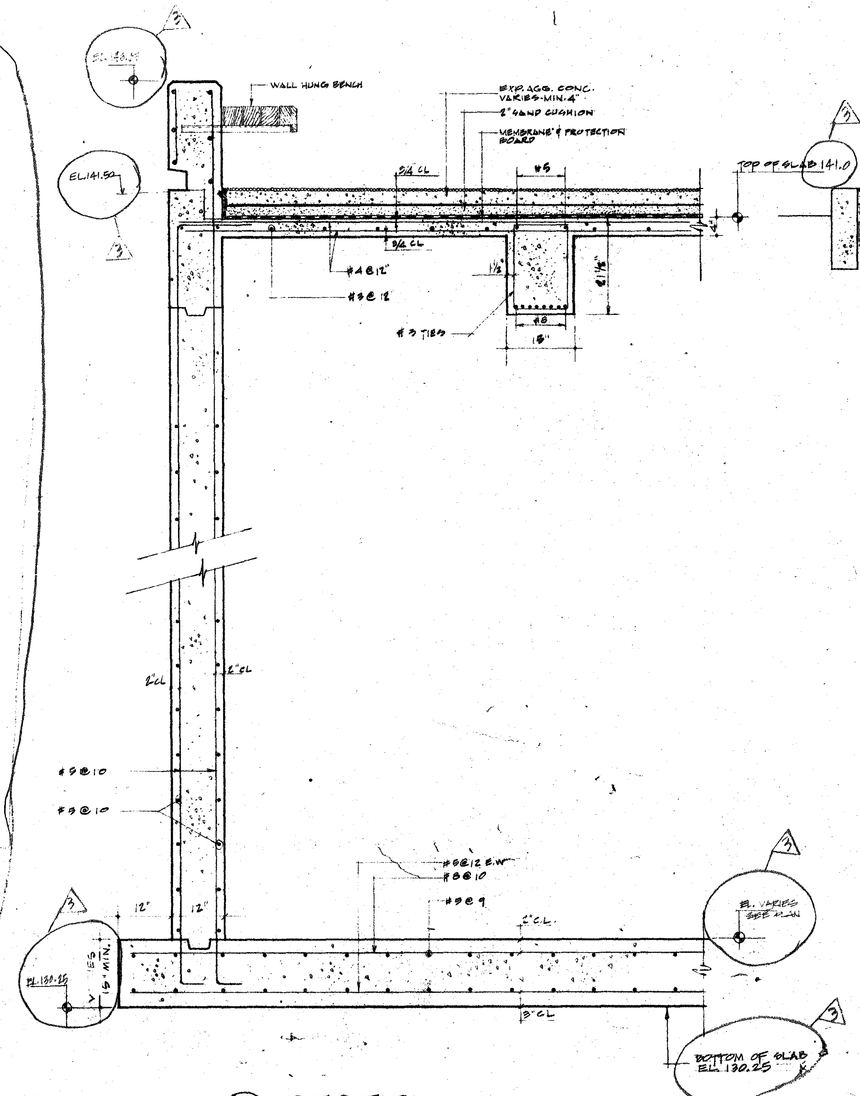

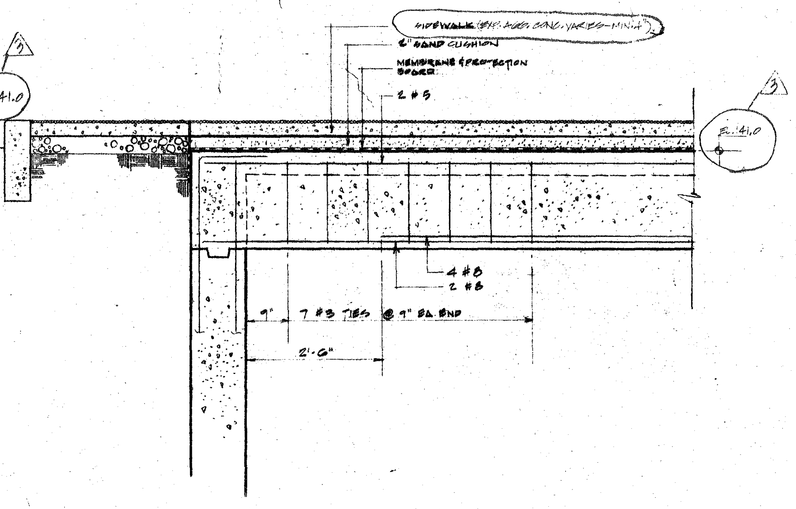

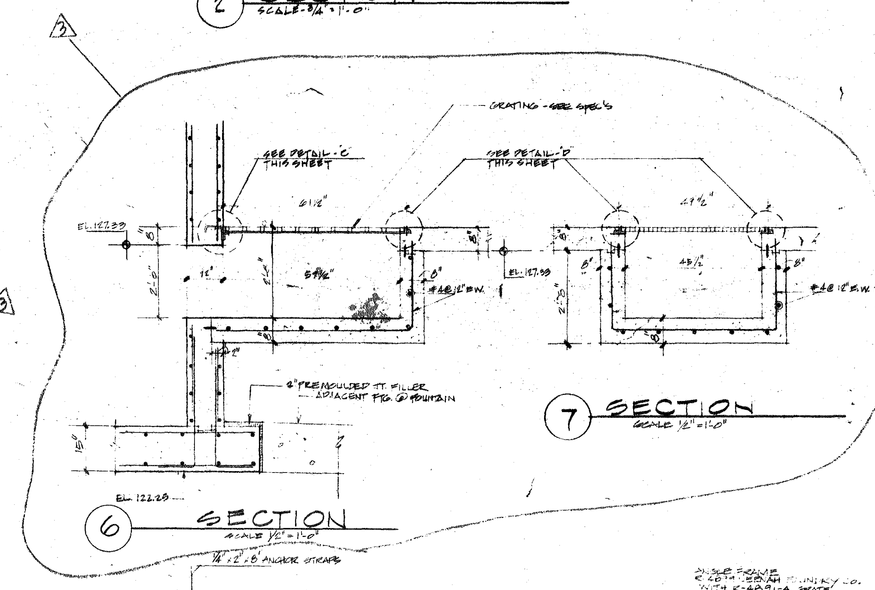

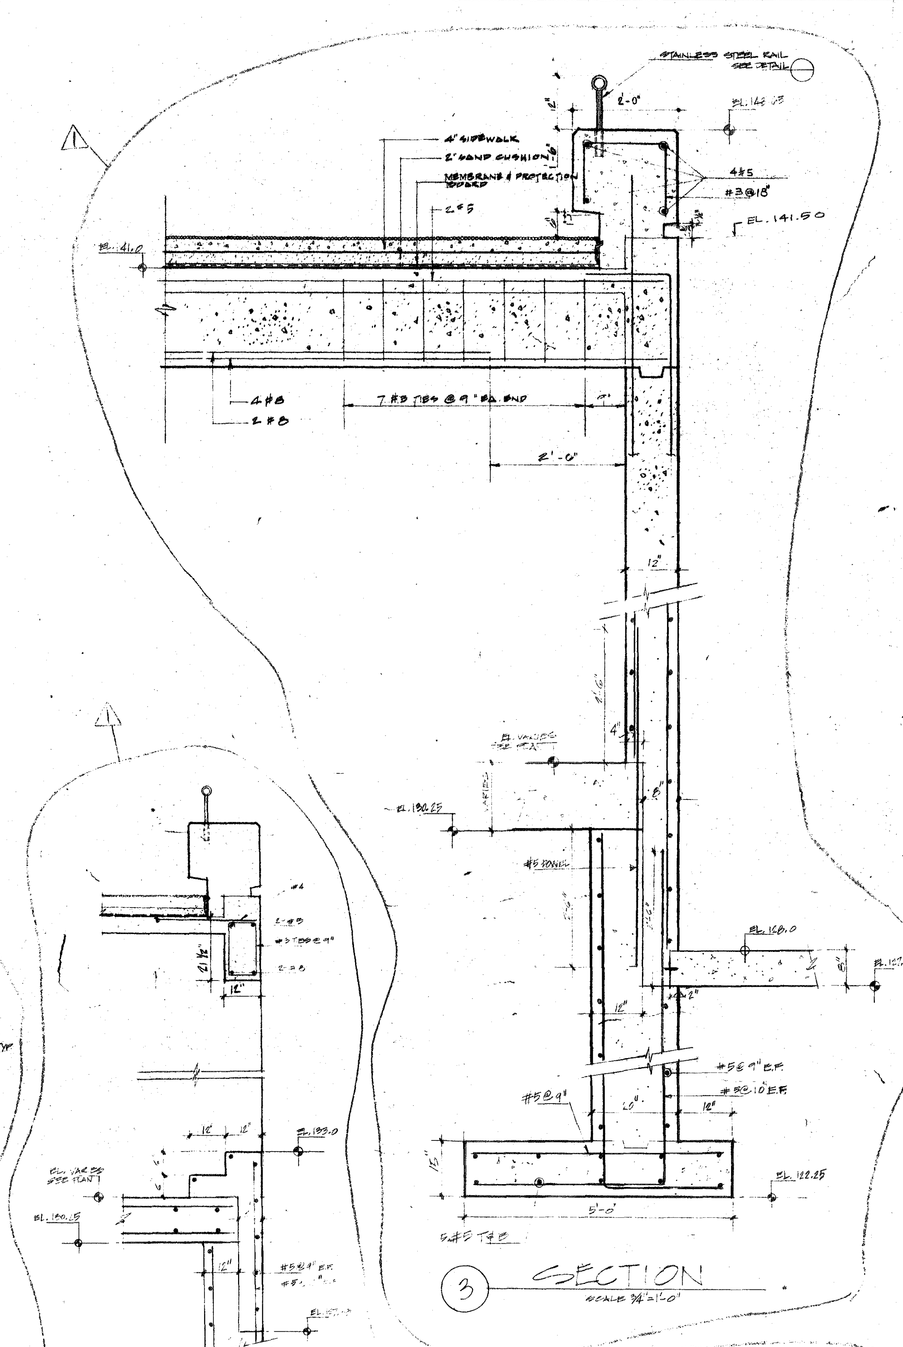

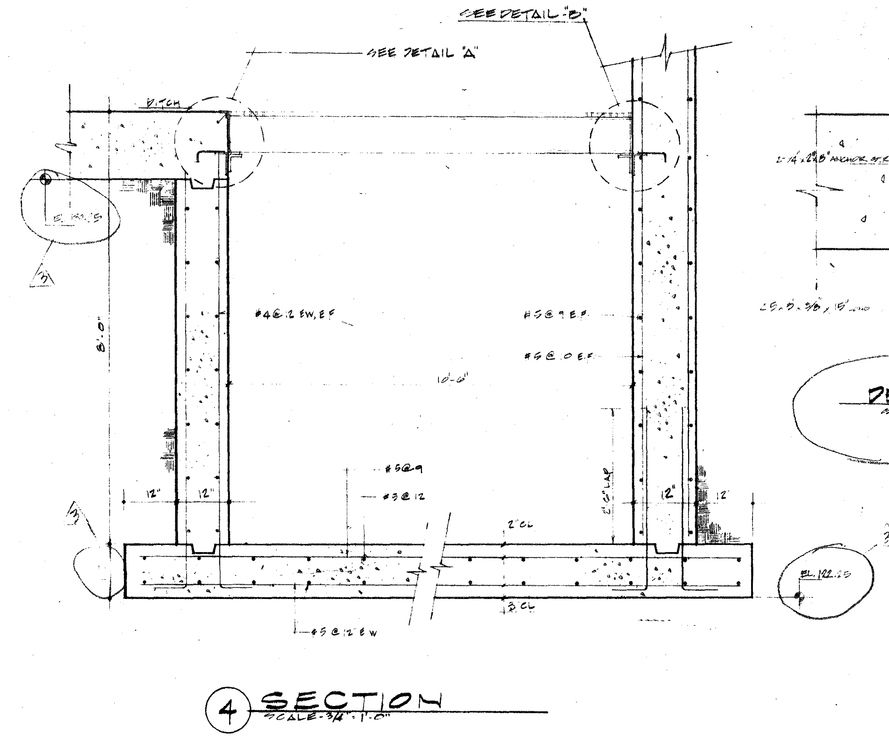

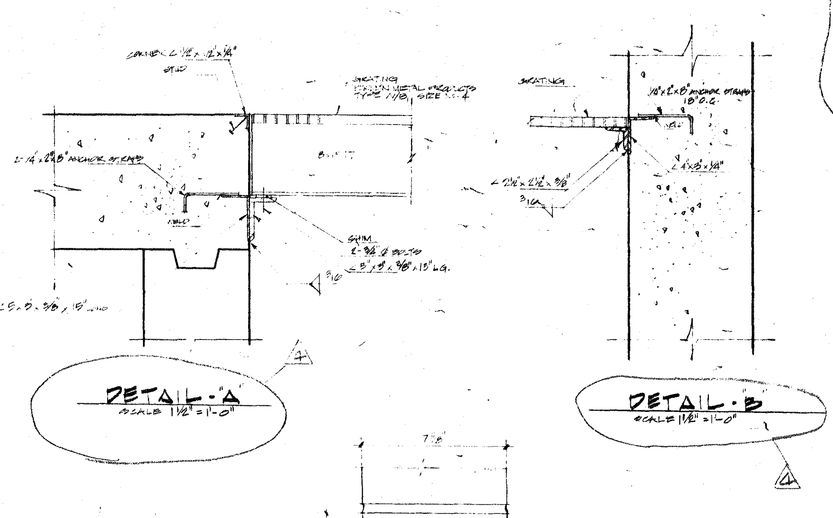

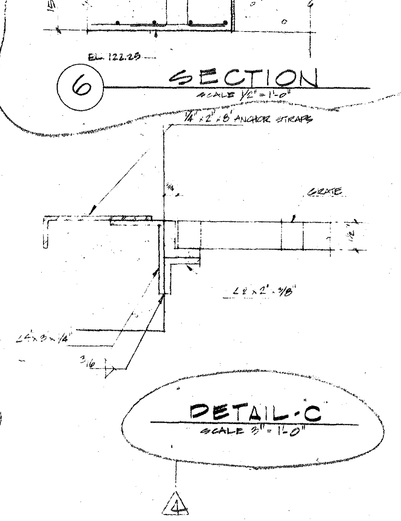

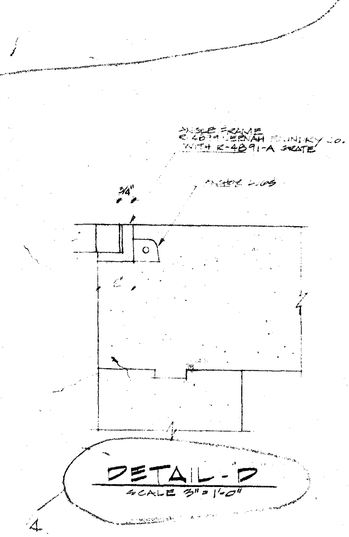

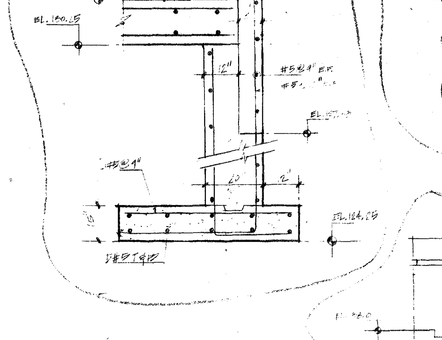

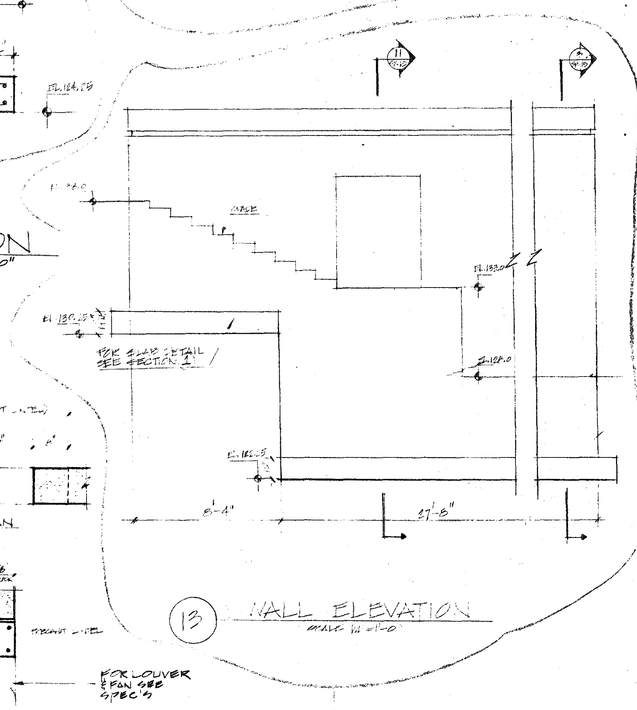

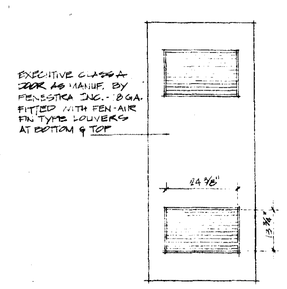

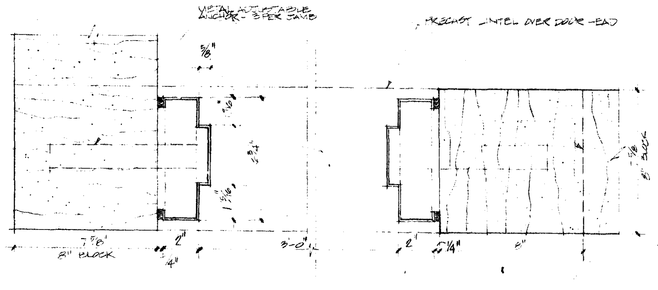

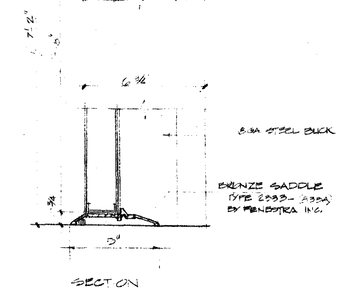

5 DOOR DETAILS

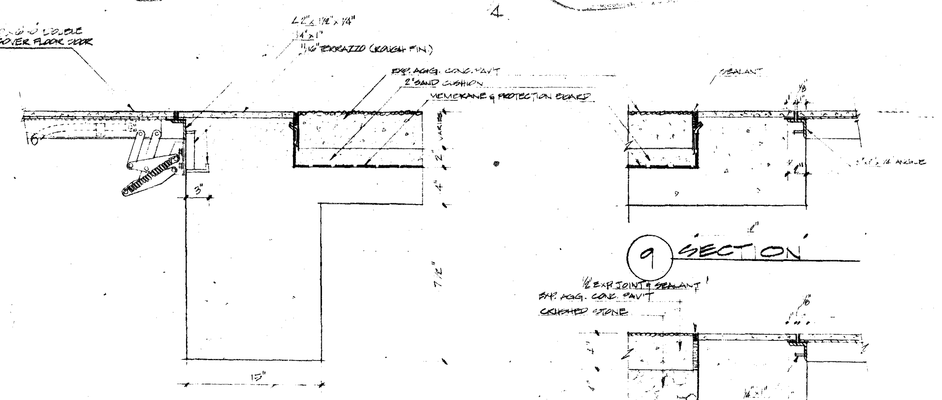

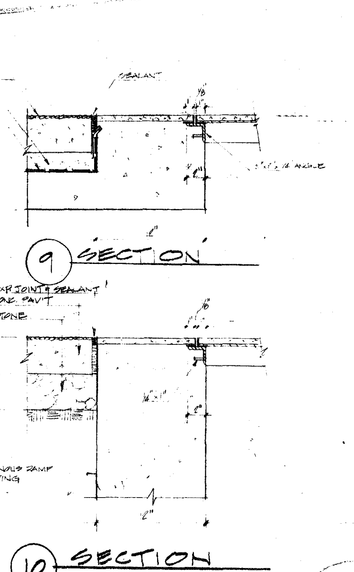

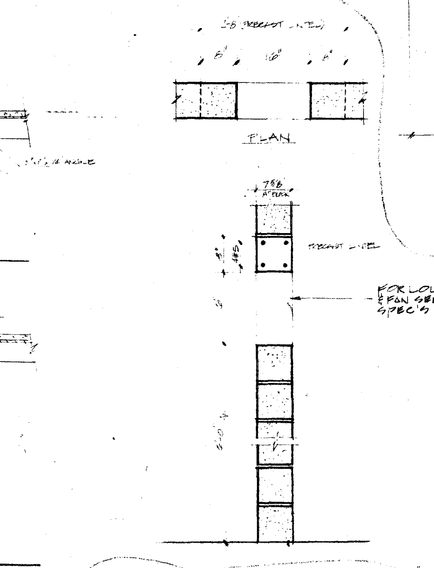

COVER FLOOR DOOR
SCALE 1 1/2" = 1'-0"

M. PAUL FRIEDBERG & ASSOCIATES

LANDSCAPE ARCHITECTURE
URBAN DESIGN

6 W. 62 ST. NEW YORK
N.Y. 10023

REGISTERED IN MINNESOTA
APP. ED PARK BLD PRELIMINARY

REVISIONS	DATE
ADDENDA #1	6-6-74
1 REVISED DETAIL NO 3 & 11 SHOWING CONDITION @ FOOTING & ELEVATION OF W. & NOTCH	
2 ADDED DETAIL No. 13	
3 ADDED DIMENSION & ELEVATIONS REF. 1, 4, 6, 7, PLAN & HEAD & SADDLE DET. & ADDED TITLE TO DET. @ SCALE TO DET. 7	
4 ADDED SCALE TO DETS. A, B C & D, B, 1 1/2" = 1'-0"	

CITY OF MINNEAPOLIS
MINNEAPOLIS., MINNESOTA

PEAVEY PARK PLAZA

MINNEAPOLIS., MINNESOTA

ASSOCIATE IN CHARGE	A.C. PEARSON
PROJECT ARCHITECT	JAY A. GOLD
DRAWN BY	CHECKED BY
SCALE AS SHOWN	DATE 5-21-74

TITLE

MECHANICAL ROOM PLAN AND DETAILS

MPF JOB # 2073 | DWG. No. SP-15

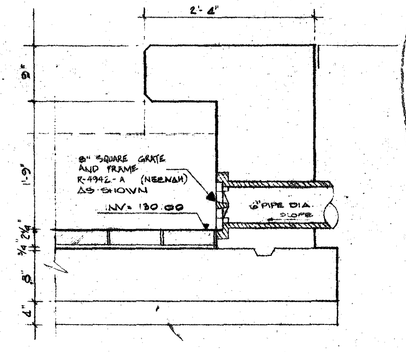

PIPE AT POOL WALL
DETAIL # 1
SCALE: 1"=1'-0"

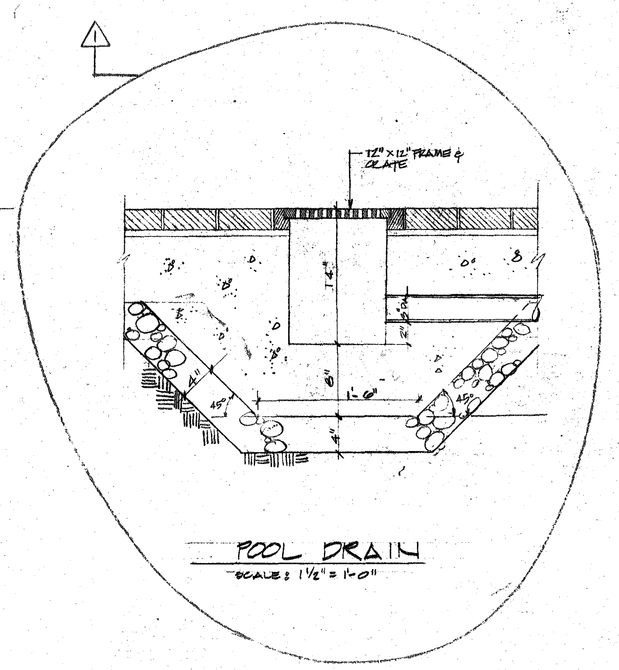

POOL DRAIN
SCALE: 1 1/2" = 1'-0"

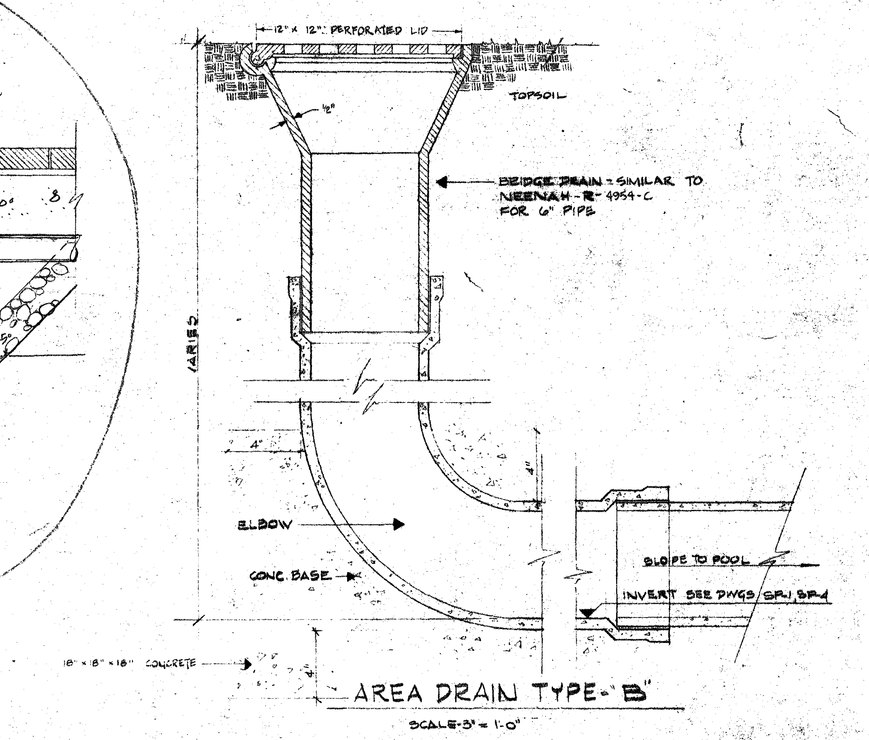

AREA DRAIN TYPE - "B"
SCALE: 3" = 1'-0"

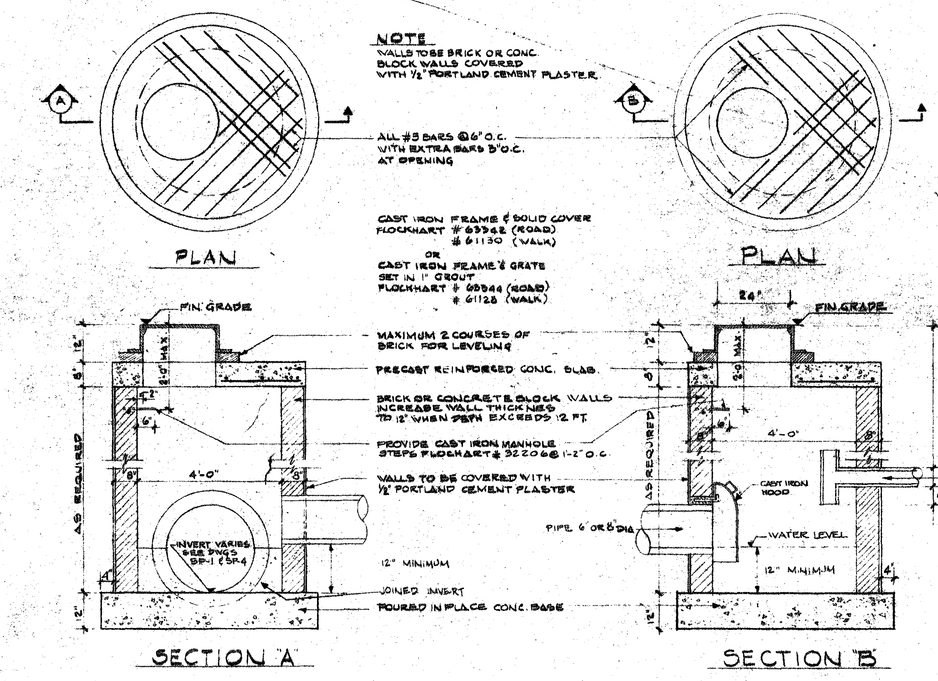

DRAINAGE MANHOLE "A"
FOR PIPES TO 30" DIA.
SCALE: ½" = 1'-0"

SANITARY SEWER MANHOLE "B"
SCALE ½" = 1'-0"

M. PAUL FRIEDBERG & ASSOCIATES
LANDSCAPE ARCHITECTURE URBAN DESIGN
6 W. 52 ST. NEW YORK N.Y. 10023

REGISTRATION IN MINNESOTA APPLIED FOR AND PENDING

REVISIONS	DATE
ADDENDA #1	6-6-74
1 COMPLETED POOL DRAIN DETAIL	

CITY OF MINNEAPOLIS
MINNEAPOLIS, MINNESOTA

PEAVEY PARK PLAZA
MINNEAPOLIS MINNESOTA

ASSOCIATE IN CHARGE	A.C. PEARSON
PROJECT ARCHITECT	JAY A. GOLD
DRAWN BY	CHECKED BY
SCALE AS SHOWN	DATE 5-21-74

TITLE
PLUMBING DETAILS

MPP JOB # 2073
DWG. No. SP-16

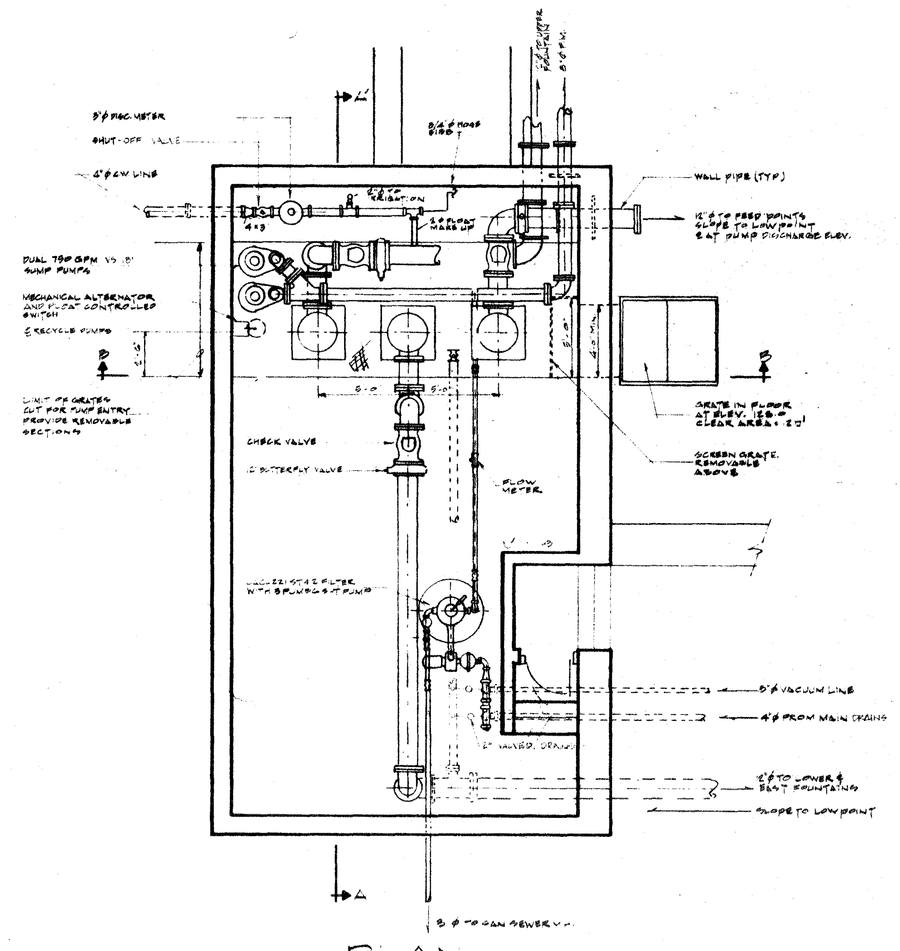

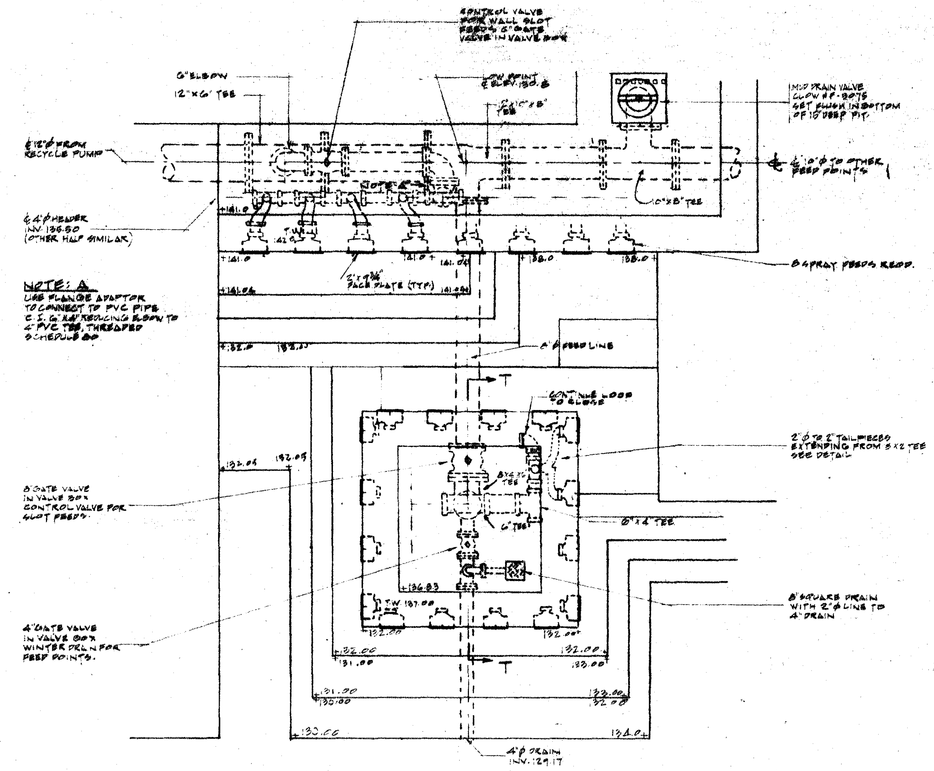

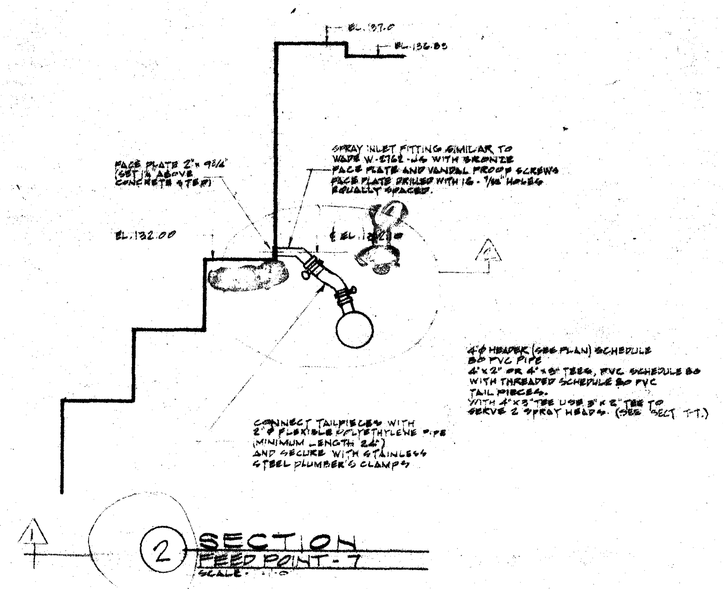

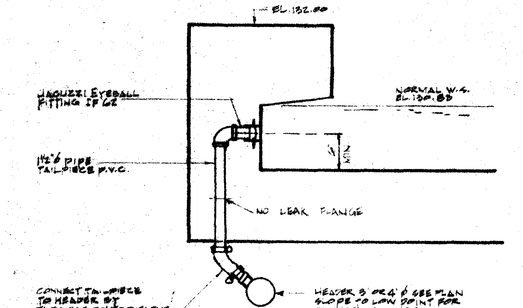

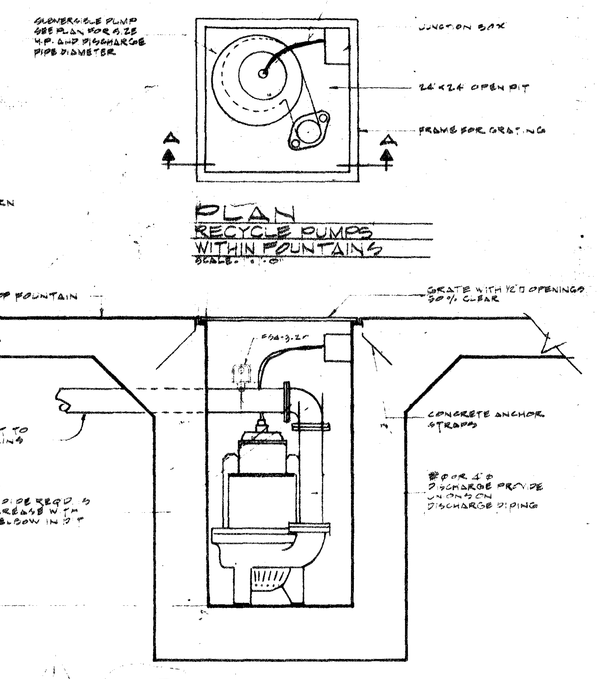


NOTE: ALL GRATES TO BE FLUSH WITH FINISHED FLOOR. ALL GRATES TO BE SECURED WITH VANDAL PROOF SCREWS. GRATE TO HAVE 12" CLEAR OPENING WITH 50% OF GRATE OPEN

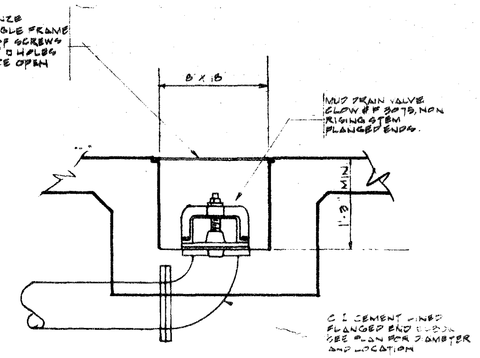

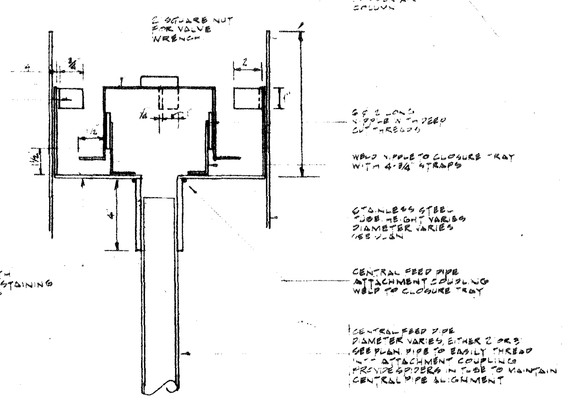

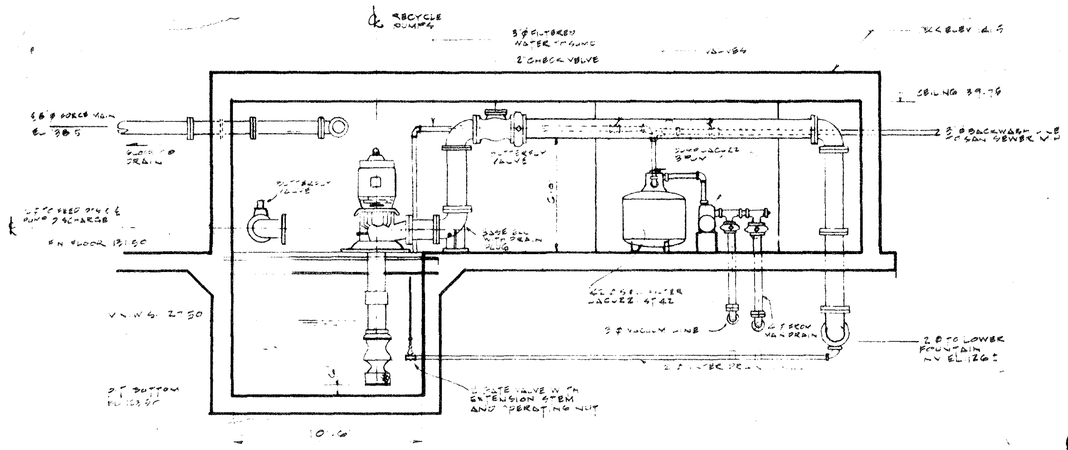
RECYCLE PUMPS
3/4" GATE VALVE
3/4" CHECK VALVE
CONCRETE ANCHOR STRAPS
3/4" P.V.C. DISCHARGE PIPE
3/4" VACUUM LINE
3/4" DRAIN LINE

PANEL "L" SCHEDULE

NAME	VOLT	MAINS	NEMA CAT	CKT #	DESCRIPTION OF LOAD	POLE	SWITCH AMPS	SWITCH FUSE	CIRCUIT WIRING NO	CIRCUIT WIRING AMG		REMARKS
L	110/208V 3Φ 4W	225A	FS UU LR LP	1,3,5	MECH. RM. LTS. RECEPT	1	30	20	2	12	3/4" C	GFI REC CKT
				2	HEATERS	3	60	50	3	6	1" C	
				7,9	BOLLARD LTS	1	30	20	2	10	3/4" C	
				11	TREE UPLIGHTS	1	30	20	2	10	3/4" C	
				4,6,8	FOUNTAIN LTS	1	30	20	2	12	SRE 3#10 SP-S	GF E
				10,13,16	"	1	30	20	2	12	SRE 3#10 SP-S	GF E
				16,18	"	1	30	20	2	10	SRE 3#10 SP-S	GF E
				13,15	SITE RECEPTACLES	1	30	20	SEE DWG		SP-S	GF E
				17,19	TREE UPLIGHTS	1	30	20	2	12	1" C	
				20,22	TREE BNLTS	1	30	20	2	12	1" C	
				21,23,25	TREE BNLTS	1	30	20	2	12	1" C	
				28	TREE UPLIGHTS	1	30	20	2	12	3/4" C	
				27,29,31	STAGE LTS	3	30	20	4	8	SRE 3#6 SP-E	
				33,34	BANNER LTS	2	30	30	2	10	SRE 3#8 SP-S	
				37	SPARE							
				38	SPACE		2	60				
				39-41	SPARE		1	30				
				42-47	SPACE		1	30				

MOTOR CONTROL SCHEDULE

MOTOR	LOCATION	HP	PH	V	CONTROLLER (SEE NOTES)	EXTERNAL CONTROL & SAFETIES
P2	MECH. ROOM	50	3	208	(1) SSPB (2) AUX.	LOW WATER RELAY CUT OUT SEE DIAGRAM
P1	"	50	3	208	(1) HOA (2) AUX.	AUTO START FROM P-2 LOW WATERCUT OUT SEE DIAGRAM
P3	"	50	3	208	(1) HOA (2) AUX	AUTO START FROM P1 LOW WATERCUTOUTSEE DIAGRAM
SUMP 1	"	5	3	208	(1) HOA (1) AUX.	FLOAT SWITCH (FS) ALARM AND ALTERNATOR FOR LEAD PUMP SUPPLIED BY PLUMBING CONTRACTOR
SUMP 2	"	5	3	208	(1) HOA (1) AUX.	
FILTER	"	3	3	208	(1) HOA (1) AUX.	AUTOMATIC POSITION TO HAVE TORK # 2007 OR EQUAL AUTOMATIC TIMER AS UNI-SOB CONTROL
S1	IN POOL	10	3	208	(1) SSPB (1) AUX.	SAFETY SHUT OFF WATER FLOW SWITCH IN UNDER WATER PIPE BY PLBG CONTR
S2,S4,S6	"	5	3	208	(1) SSPB (1) AUX	
S3 S5	"	3	3	208	(1) SSPB (1) AUX.	
FAN	MECH ROOM	1/2	1	120	MANUAL SWITCH WITH OL CUT OUT	HUMIDISTAT AND THERMOSTAT TURN FAN ON IN HIGH HUMIDITY OR TEMPERATURE

NOTES

REFERENCES OF CONTROLLERS SHALL BE AS FOLLOWS
(1) ACROSS THE LINE MAGNET (EXCEPT AS OTHERWISE REQUIRED BY UTILITY CO) WITH FUSED DISCONNECT, CONTROL TRANSFORMER AND (3) OVER LOAD CUT OUTS AND PILOT LIGHT IN COVER
SSPB — START STOP PUSH BUTTON IN COVER
HOA — HAND-OFF AUTOMATIC SWITCH IN COVER
(2) AUX — AUXILIARY NORMALLY OPEN CONTACTS, QUANTITY IN PARENTHESIS. (NOT ALWAYS USED)

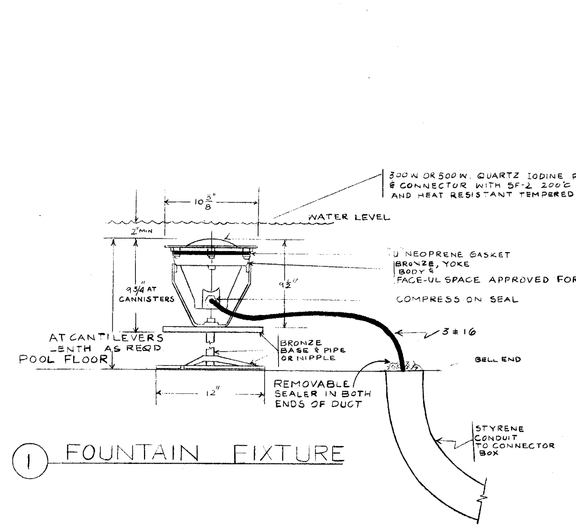

1 FOUNTAIN FIXTURE

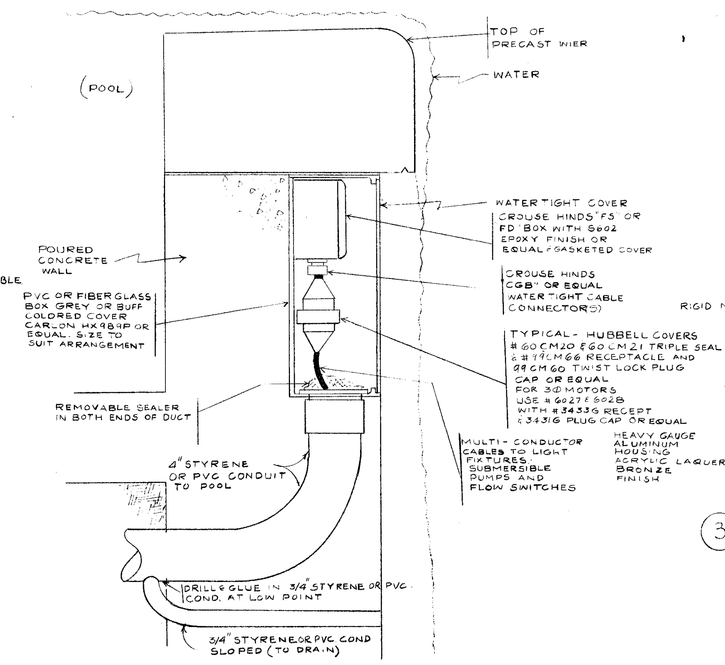

2 TYPE "J2" JUNCTION BOX

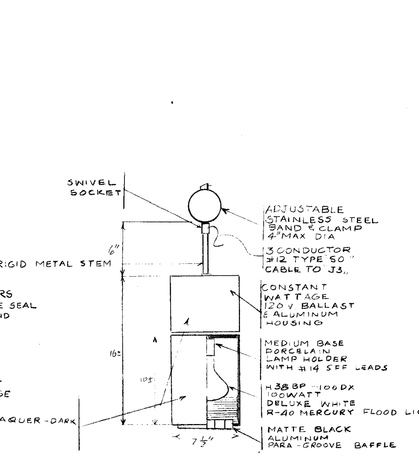

3 TYPICAL TREE LIGHT

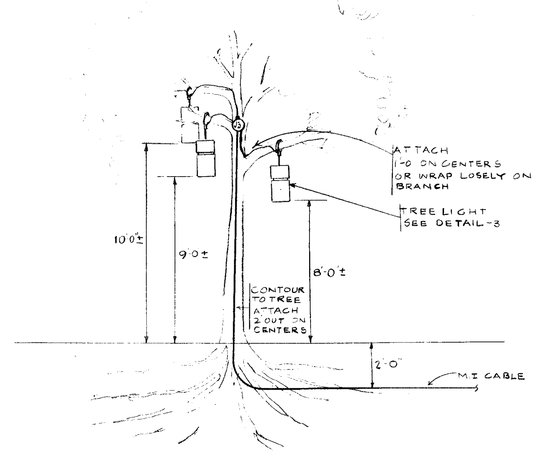

4 TYPICAL TREE LIGHTING

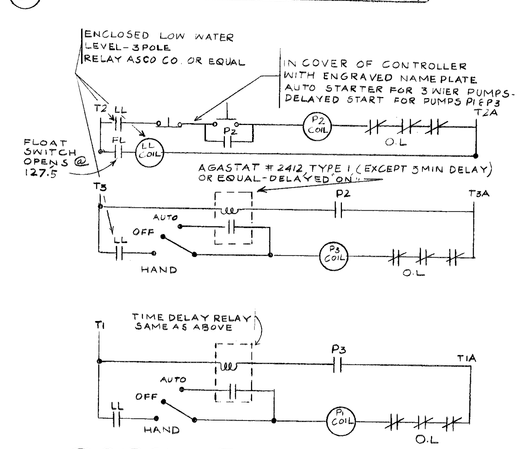

5 CIRCULATING PUMP DIAGRAM

NOTE - ALL PARTS SHOWN ABOVE BY ELECTRICAL CONTRACTOR

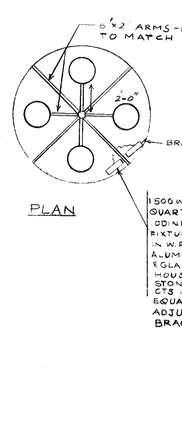

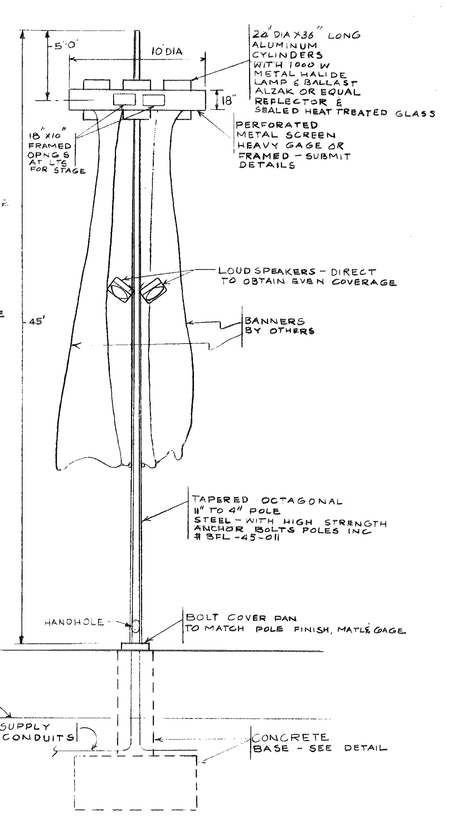

7 FLOOD LIGHTING - BANNER STANDARD

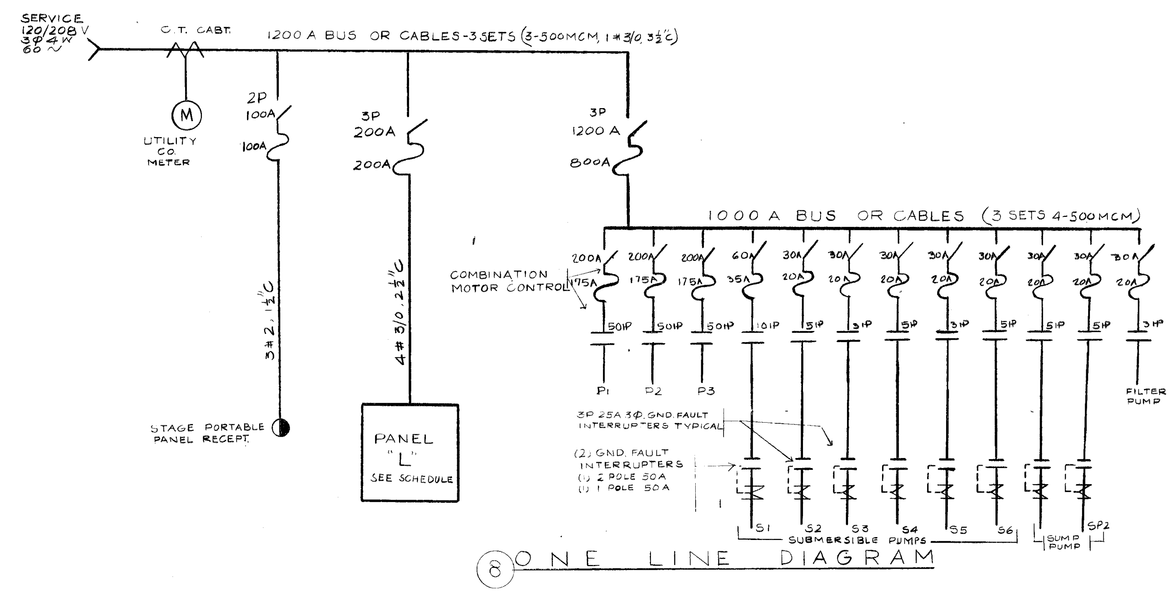

8 ONE LINE DIAGRAM

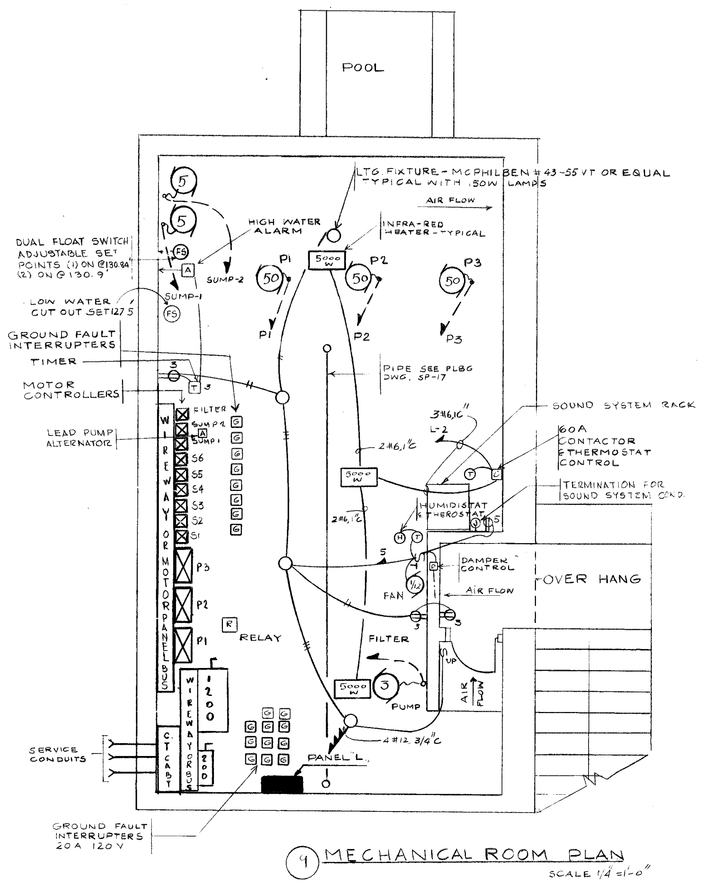

9 MECHANICAL ROOM PLAN

SCALE 1/4" = 1'-0"

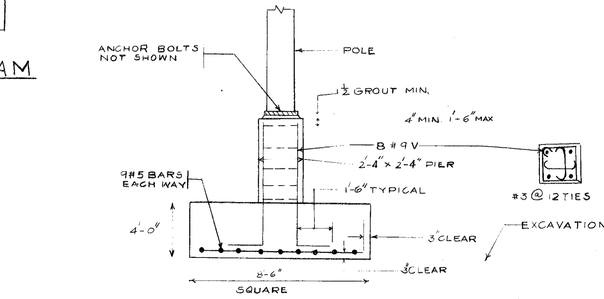

6 TYPICAL PIER & FOOTING DETAIL

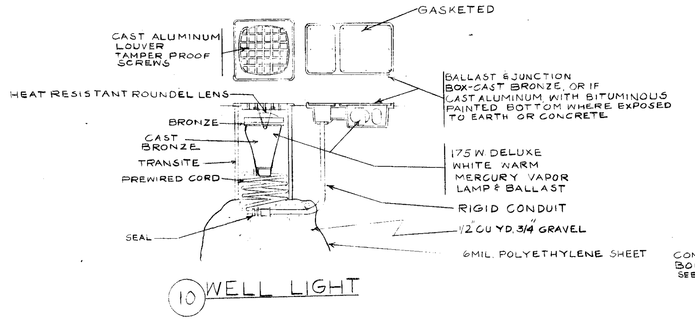

10 WELL LIGHT

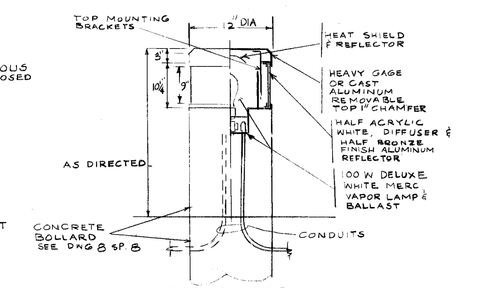

11 BOLLARD LIGHT

M. PAUL FRIEDBERG & ASSOCIATES

LANDSCAPE ARCHITECTURE
URBAN DESIGN

4 W. 62 ST. NEW YORK
N.Y. 10023

PROTECTION IN MINNESOTA APPLIED FOR AND PENDING

REVISIONS	DATE

CITY OF MINNEAPOLIS
MINNEAPOLIS, MINNESOTA

PEAVEY PARK PLAZA

MINNEAPOLIS, MINNESOTA

ASSOCIATE IN CHARGE	A.C. PEARSON
PROJECT ARCHITECT	JAY A. GOLD
DRAWN BY	CHECKED BY
SCALE	DATE 5-21-74

TITLE

ELECTRICAL DETAILS

MPF JOB.#	DWG. No.
	SP-18

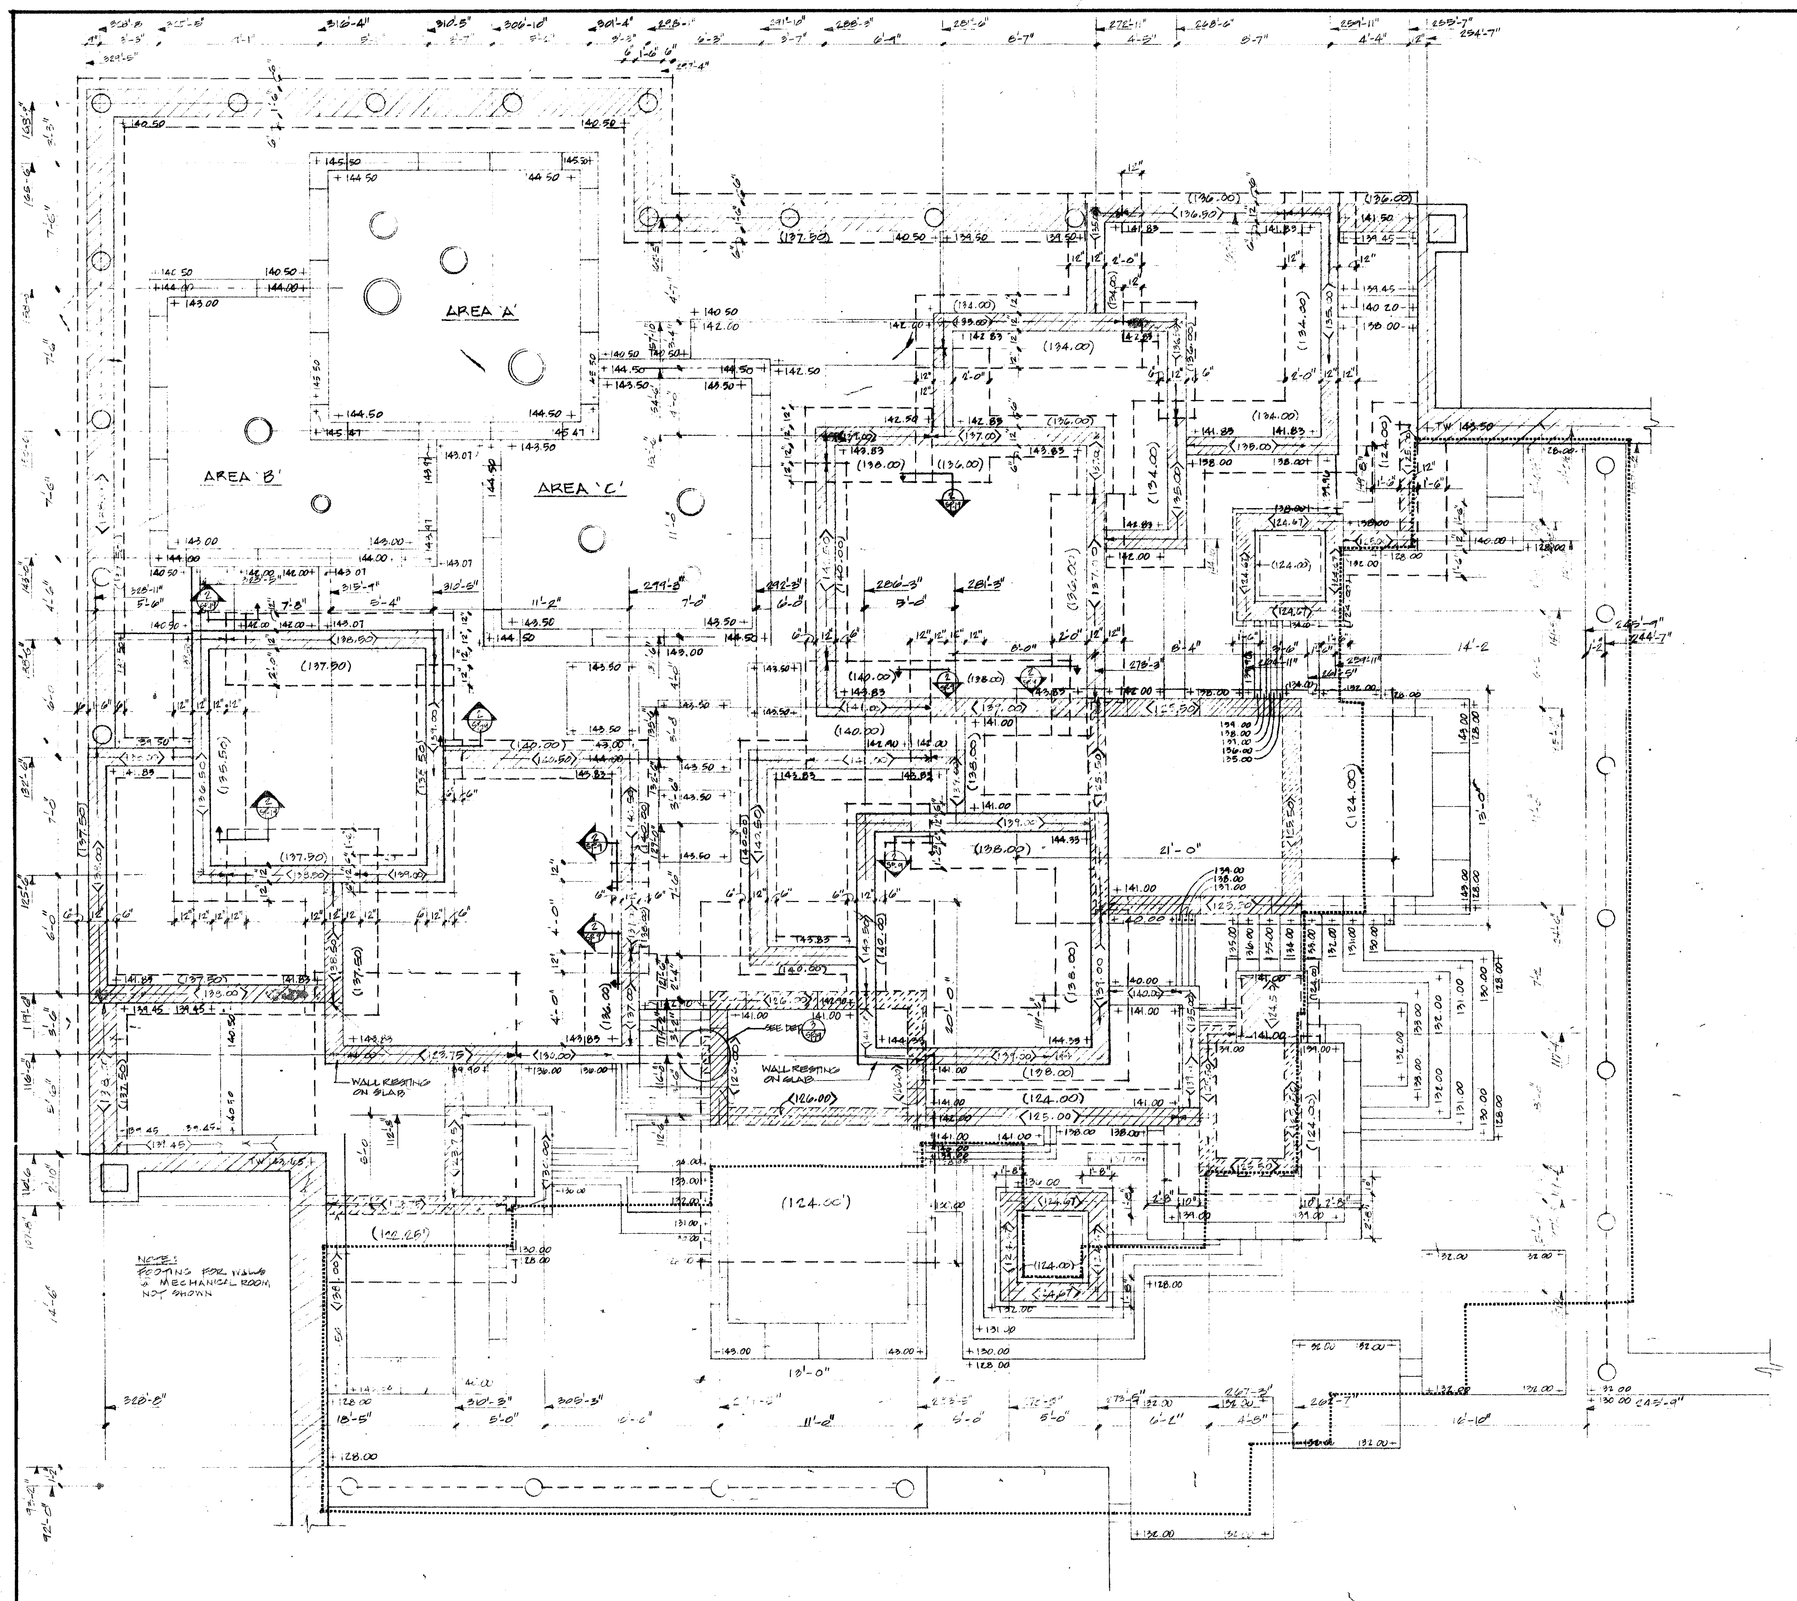

1 UPPER FOUNTAIN PLAN
SCALE: 1/8" = 1'-0"

NOTES:
( ) INDICATE BOTTOM OF FOOTING ELEVATION
( ) INDICATE BOTTOM OF WALL ELEVATION
INDICATE WALL GOING DOWN TO THE FOOTING
INDICATE LINE OF FOOTING BELOW
INDICATE WALL WITH SLAB ON TOP

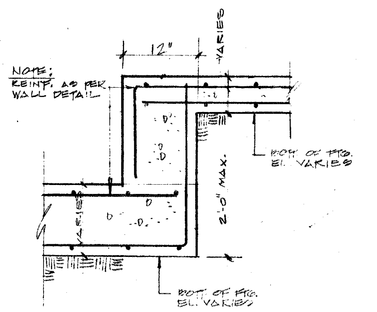

2 TYPICAL STEPPING FTG. DET.
SCALE: 1" = 1'-0"

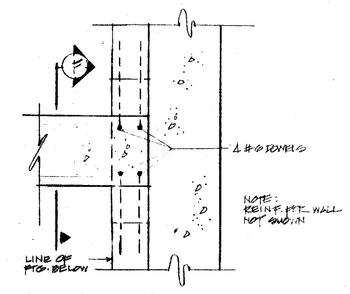

PLAN
SCALE: 1" = 1'-0"

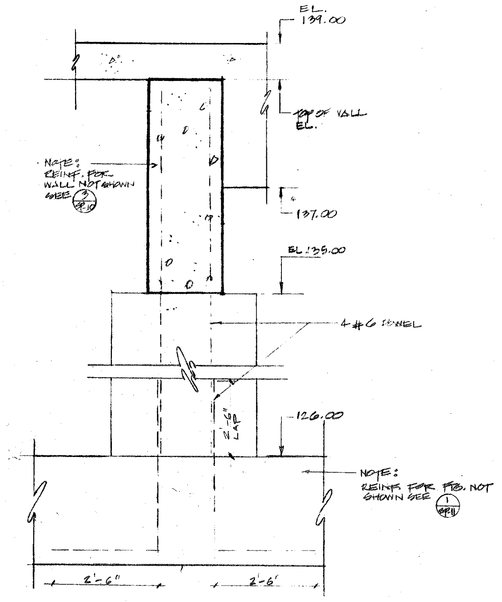

SECTION "F"
SCALE 1" = 1'-0"

M. PAUL FRIEDBERG & ASSOCIATES

LANDSCAPE ARCHITECTURE
URBAN DESIGN

4 W. 52 ST. NEW YORK
N.Y. 10023

REGISTERED IN MINNESOTA APPLIED FOR AND PENDING.

REVISIONS	DATE
ADDENDA No 1	6-6-74
1 LEAVE TWG.	

CITY OF MINNEAPOLIS
MINNEAPOLIS, MINNESOTA

PEAVEY PARK PLAZA
MINNEAPOLIS, MINNESOTA

ASSOCIATE IN CHARGE	A.C. PEARSON
PROJECT ARCHITECT	JAY A. GOLD
DRAWN BY	CHECKED BY
SCALE AS SHOWN	DATE 5-21-74

TITLE
FOUNTAIN PLAN

MPF JOB.#	DWG. No.
2073	SP-9